
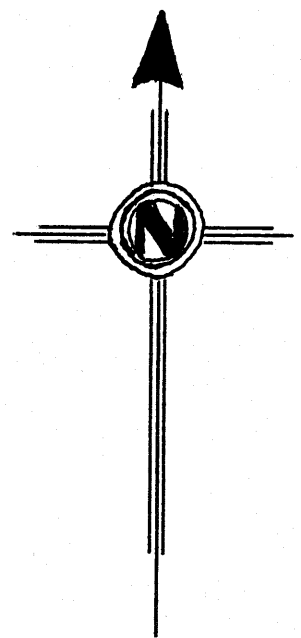


R 54 E

T 22 N

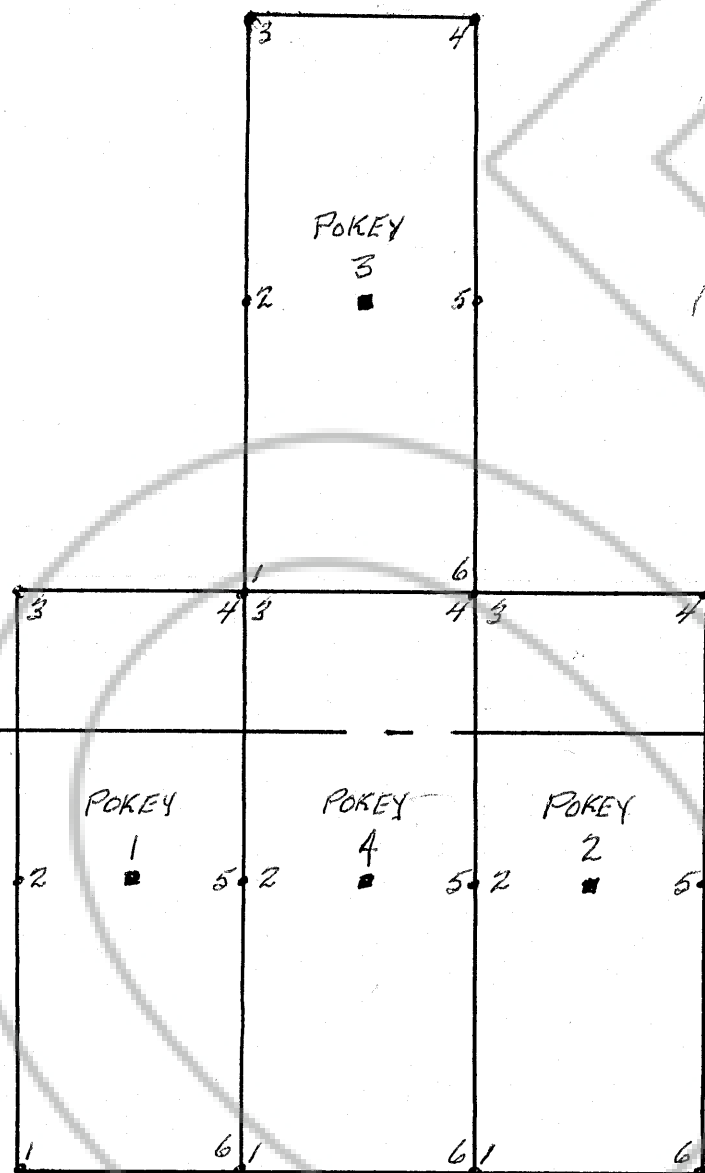

Staked During January 1972 By G. Stewart & P Gamboa

FOR

CARY STEWART & ASSOCIATES

East Ely,

Nevada

POKEY CLAIM GROUP
DIAMOND MINING DISTRICT

Eureka County

Nevada

Scale - 1" = 500' Date Feb 16, 1972

SDC - P-1

Mapping Gary Stewart

Drafting Jim Reza

Revised March 18, 1972

Filed
RECORDED AT THE REQUEST OF Gary Stewart
on April 13, 1972, at 45 mins. past 1 P. M. in
BOOK ~~XXXX~~ ~~XXXXXX~~ RECORDS OF
EUREKA COUNTY, NEVADA *William A. DeLoach* Recorder.
File No. 55916 Fee \$ 60.00