


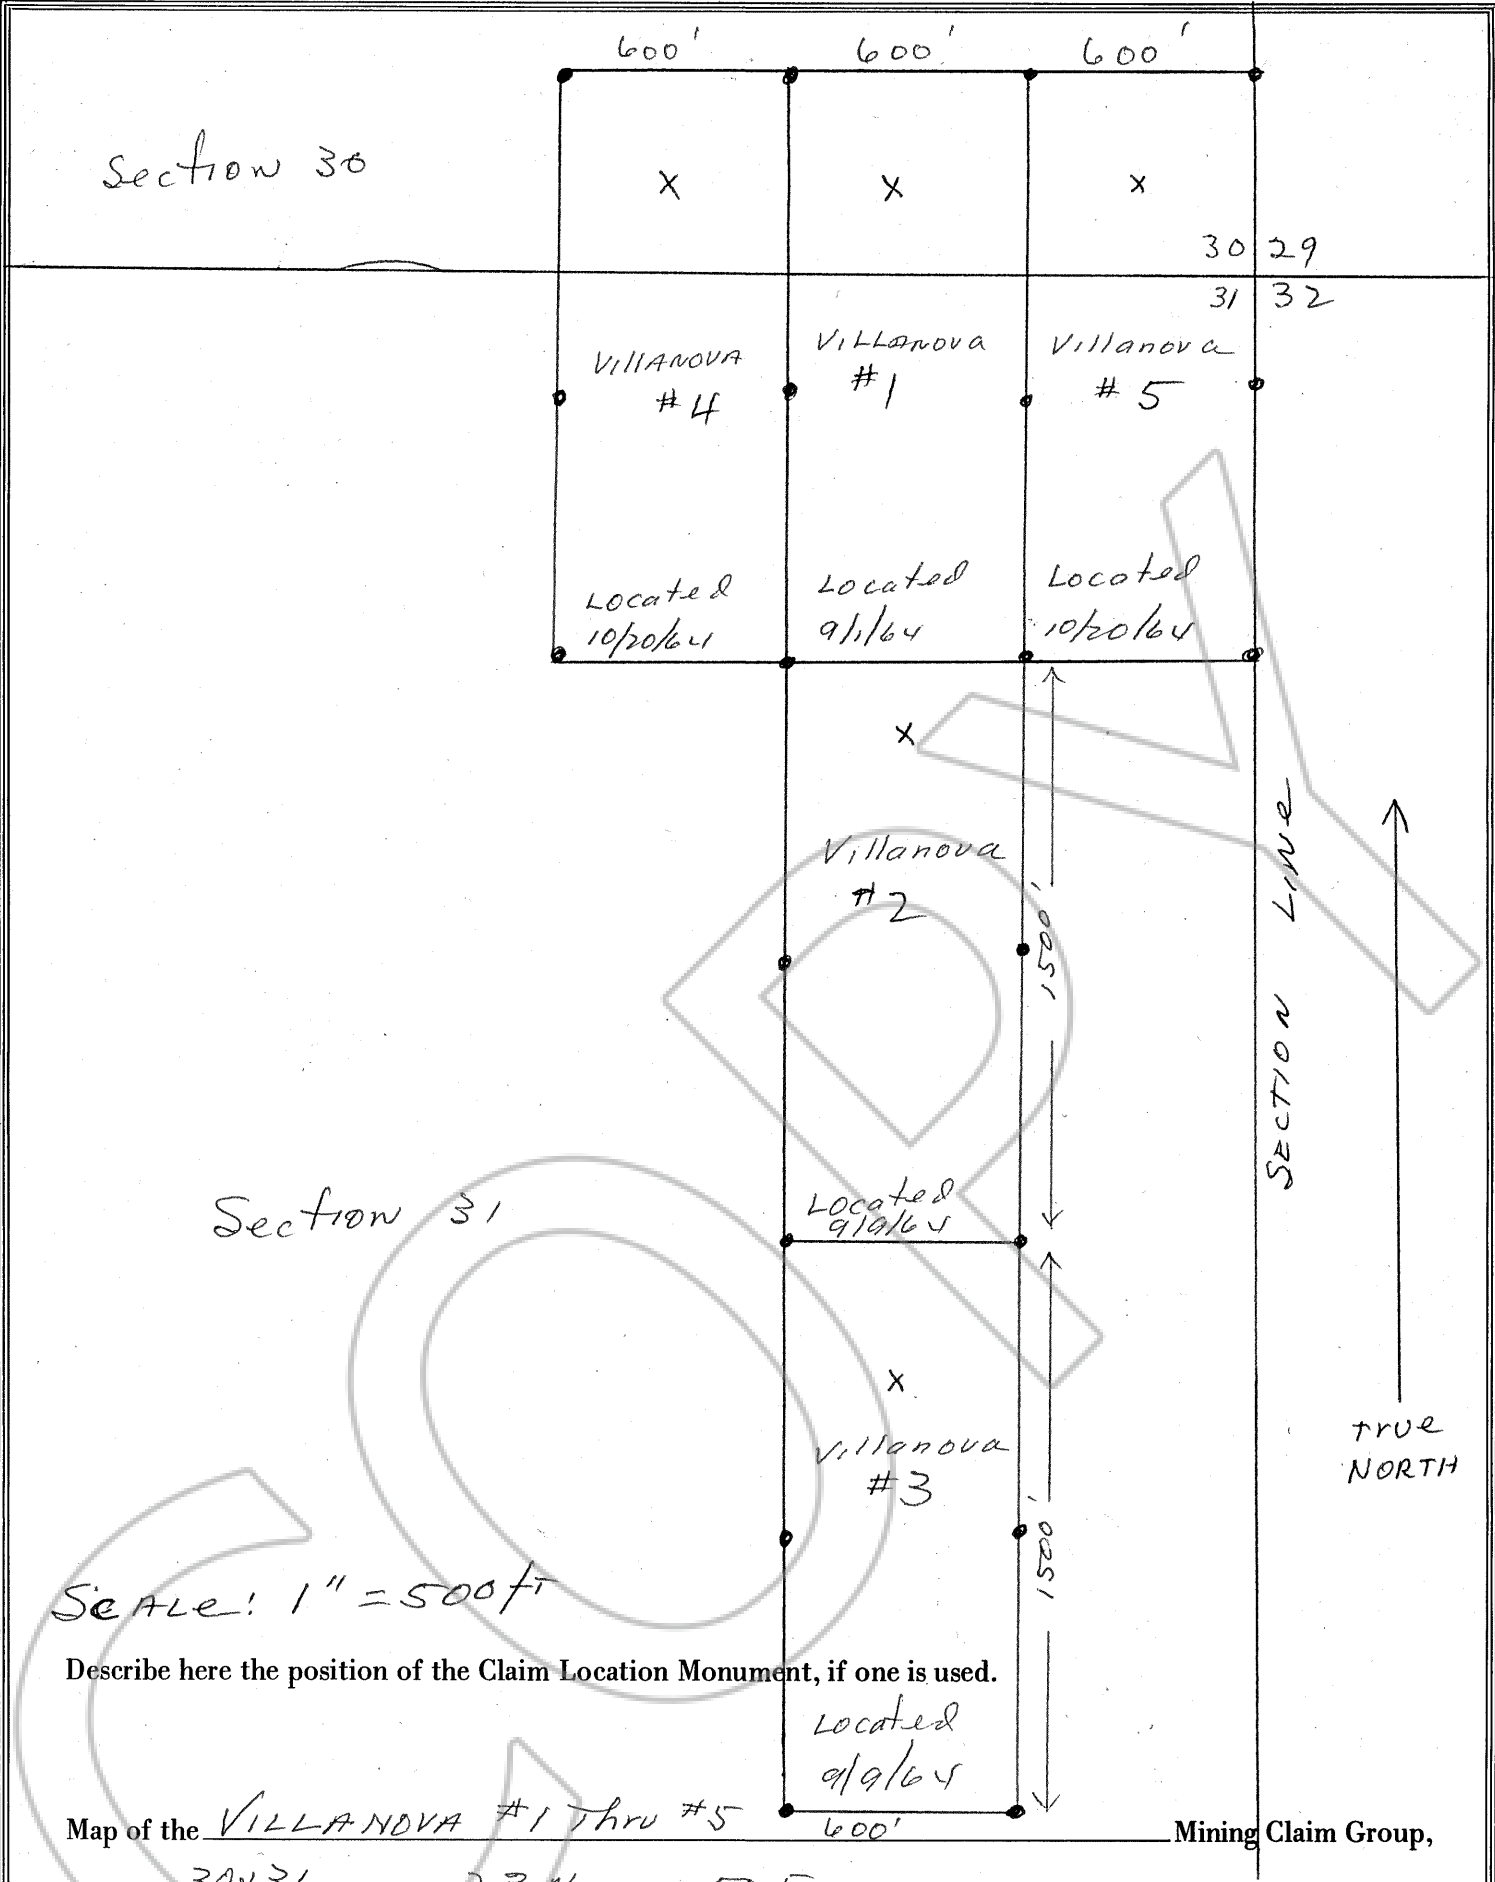

SCALE: 1" = 500'

Describe here the position of the Claim Location Monument, if one is used.

Map of the VILLANOVA #1 Thru #5 Mining Claim Group,
in Section 30 & 31 Township, 23 N Range 50 E,
in the UNKNOWN Mining District,
EUREKA County, Nevada.

Located on the _____ day of _____, 19____, by
PETER J. Damele

Locator name and address (please print)
PETER Damele & Sons
EUREKA, NEVADA

RECORDER'S STAMP

Filed
~~RECORDED~~ AT THE REQUEST OF
Bernard Damele
on August 29 19 72
at 05 mins. past 10 A. M.
~~XXXXXXXXXXXXXXXXXXXX~~
~~XXXXXXXXXXXX~~ RECORDS
OF EUREKA COUNTY, NEVADA.
Willis A. DePaoli
Recorder
File No. 56308 Fee \$ ----
File No. 56308