
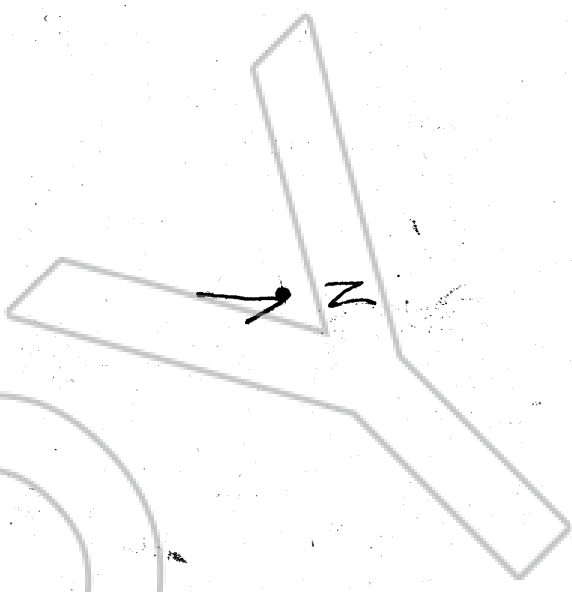


1" = 400'

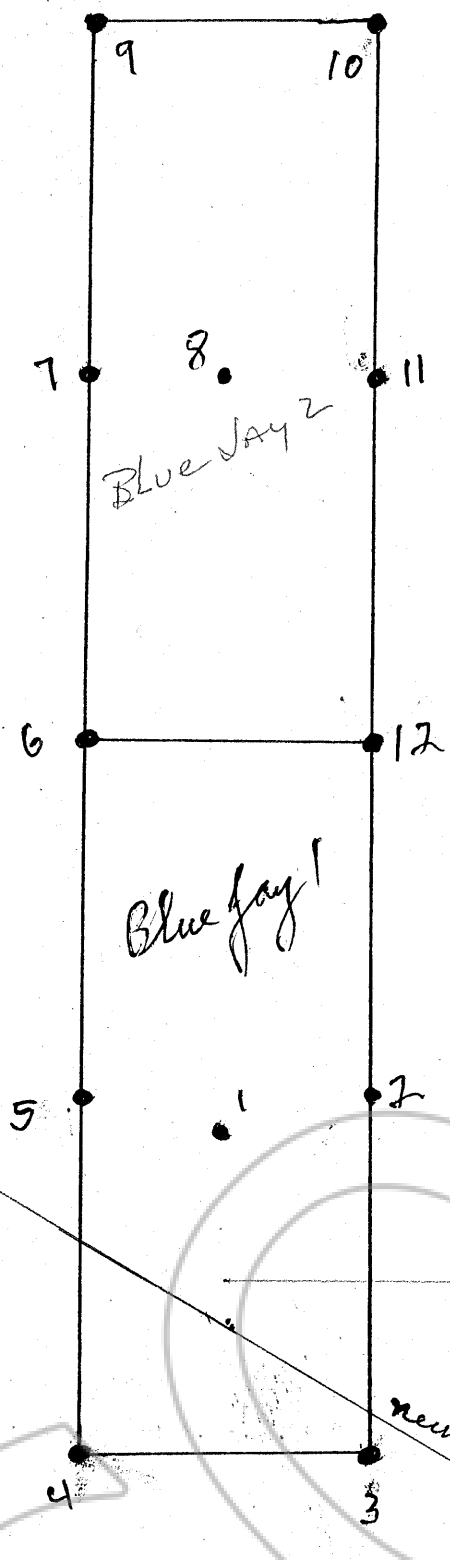

Describe here the position of the Claim Location Monument, if one is used.

← Sec 23.24
 25.26
 53E 19N
 MDBM

Map of the ~~Blue Bird~~ Blue Jay Mining Claim Group,
 in Section 24 Township, 19N Range 3E,
 in the EUREKA Mining District,
 Eureka County, Nevada.

Located on the 28 day of June, 1963, by
 Peter Evans & INEZ JENSEN
 Locator name and address (please print)
 Peter Evans - Eureka, Nevada
 Ron Hendricks

RECORDER'S STAMP

Filed
~~RECORDED~~ AT THE REQUEST OF
 Pete Evans
 on August 31 1, 1972
 at 55 mins. past 8 A. M.
~~XXXXXXXXXXXXXXXXXXXX~~
 RECORDS DEPT. RECORDS
 OF EUREKA COUNTY, NEVADA.
 Recorder *Melvin A. Stewart*
 File No. 56400 es 3.00