


T. 30N R. 50E

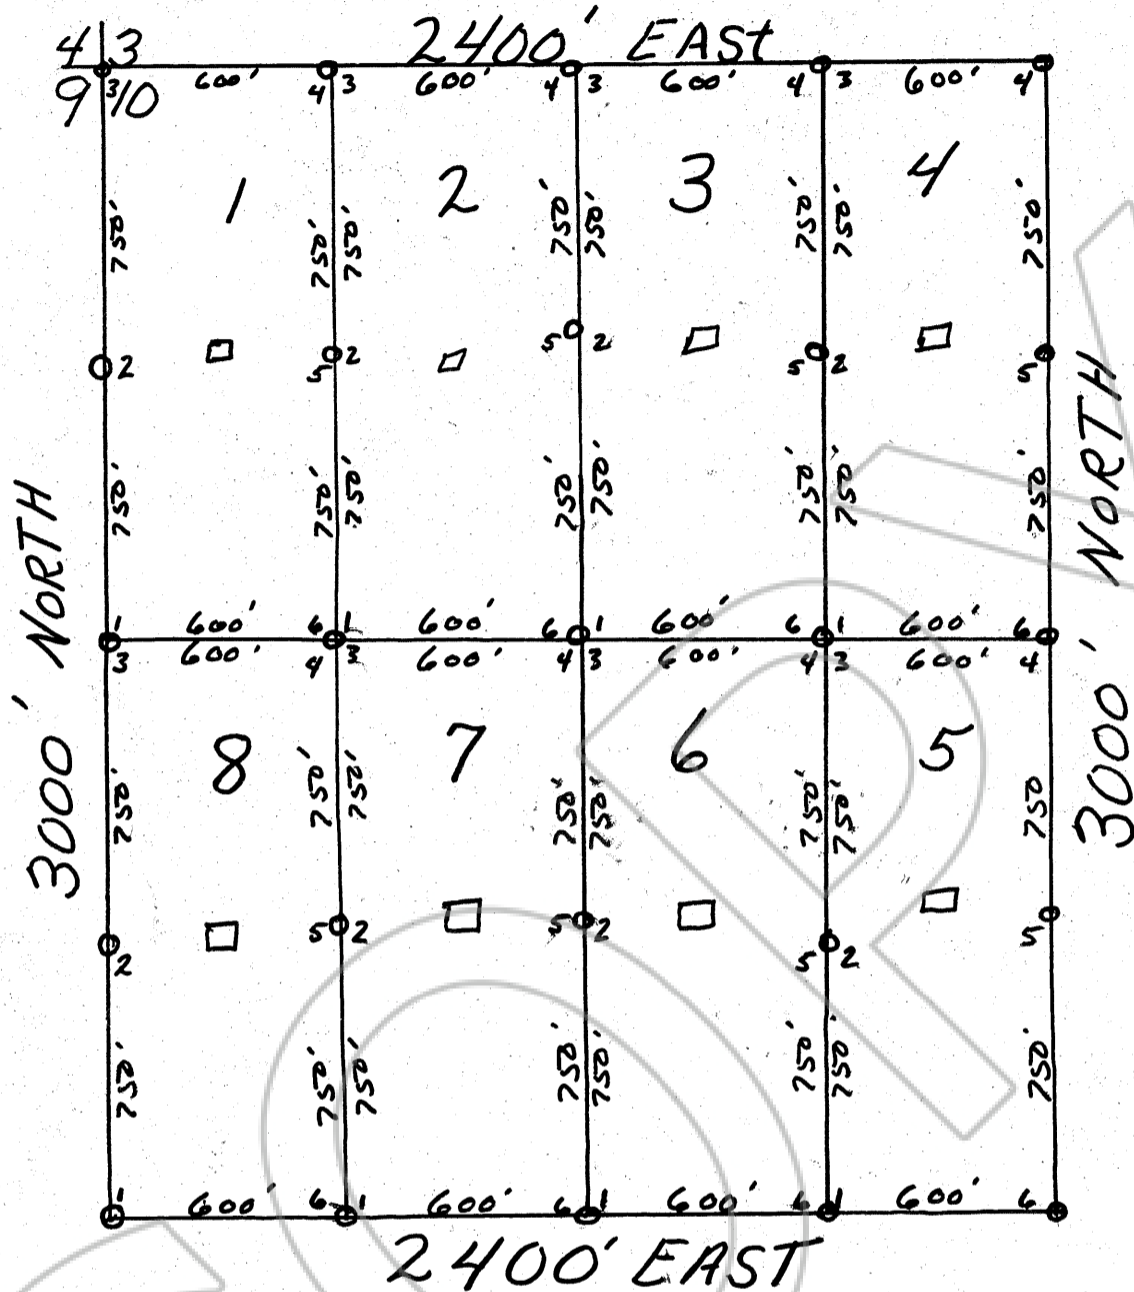

1" = 500'

Describe here the position of the Claim Location Monument, if one is used.

True North

Map of the Lucky JACK Mining Claim Group,

in Section 10 Township, 30N Range 50E,

in the _____ Mining District,

EUREKA County, Nevada.

Located on the 1st day of July, 1978, by

Freeman E. Churchfield

Locator name and address (please print)

Freeman E. Churchfield

JANE Churchfield

Pleasant Valley Eiko, Nev.

66261 RECORDER'S STAMP

Filed
RECORDED AT THE REQUEST OF
Freeman E. Churchfield
on Sept. 14, 1978
at 55 mins. past 3 P. M.
~~XXXXXXXXXXXXXXXXXXXX~~
~~RECORDED AT THE REQUEST OF~~
OF EUREKA COUNTY, NEVADA
WILL A. DePAOLI
Recorder
File No. 66261 Fee \$ 120.00