

SOUTH
15,600'

WEST

NOTE:

LOCATION DATES:

LOCATED WITHIN SECTIONS 9, 10, 11, 14, 15, 16 & 17, T. 22 N., R. 51 E.

TRUE NORTH

Filed AT THE REQUEST OF
INBERG SURVEYING CO
 on March 11, 1981
 at 59 mins. past 11 A. M.
 in of
 , , RECORDS
 OF EUREKA COUNTY, NEVADA
 WILL A. DePAOLI
 Recorder
 File No. 798895 For \$ 1305 ⁰⁰

JOB NO. 1709-81

2/26/81

SHEET 1 OF 7 SHEETS

79895

SOUTHWEST CORNER,
SECTION 30,
T. 23 N., R. 52 E., M.D.P.M.



☐ INDICATES 4"X4"X 4-1/2' WOODEN POST
OR CUT TREE MONUMENT

☒ INDICATES 4"X4"X 4-1/2' WOODEN POST
OR CUT TREE LOCATION MONUMENT

☒ LOCATION MONUMENT LOCATED 10' FROM
END LINE OF CLAIM UNLESS NOTED

15	14
22	23

INDICATES SECTION CORNER

SECTION LINES SHOWN ARE PROJECTED

LOCATION DATES:


FEBRUARY 4, 1981 799 THROUGH 820
887 THROUGH 904
975 THROUGH 978

FEBRUARY 5, 1981 821 THROUGH 828
905 THROUGH 916
979 THROUGH 1004

FEBRUARY 6, 1981 1035 THROUGH 1059 (ODD NOS.)
741 THROUGH 755
1061 AND 1063

LOCATED WITHIN SECTIONS 14, 15, 16, 17, 20, 21,
22, 23, 26, 27, 28 & 29, T. 22 N., R. 51 E.

T. 22 N.

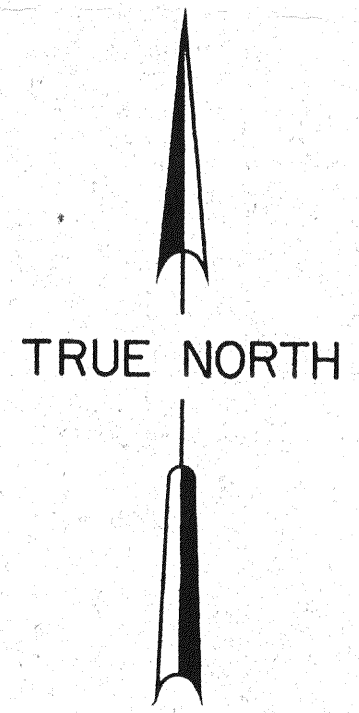

SCALE: 1" = 500'

Filed AT THE REQUEST OF
IN **BURG SURVEYING CO**
on March 11, 1981
at 59 mins. past 11 A. M.
in of
 , , Nevada
OF EUREKA COUNTY, RECORD
WILL A. DePAOLI
Recorder
File No. 79895 Fee \$ 18.00 ⁰⁰

MAP OF THE
M. H. LODGE MINING CLAIMS
MOUNT HOPE MINING DISTRICT
EUREKA COUNTY, NEVADA

LOCATED BY RICHARD D. INBERG
AGENT FOR EXXON CORPORATION
EXXON MINERALS COMPANY
P.O. BOX 120
DENVER, COLORADO 80201

SHEET 2 OF 7 SHEETS

79895

JOB NO. 1709-81

2/26/81

SOUTHWEST CORNER,
SECTION 30,
T. 23 N., R. 52 E., M.D.P.

R. 51 E.

NOTE:

- INDICATES 4"X4"X4-1/2' WOODEN POST OR CUT TREE MONUMENT
- ⊠ INDICATES 4"X4"X4-1/2' WOODEN POST OR CUT TREE LOCATION MONUMENT
- ⊠ LOCATION MONUMENT LOCATED 10' FROM END LINE OF CLAIM UNLESS NOTED

(13) (24)
(24) (25)
INDICATES SECTION CORNER

SECTION LINES SHOWN ARE PROJECTED


LOCATION DATES:

FEBRUARY 5, 1981 1036 THROUGH 1060 (EVEN NOS.)
FEBRUARY 6, 1981 1062 & 1064
FEBRUARY 7, 1981 1095 THROUGH 1122
1155 THROUGH 1180
1219 THROUGH 1240
FEBRUARY 8, 1981 1181 THROUGH 1184
1275 THROUGH 1287 (ODD NOS.)
FEBRUARY 10, 1981 1123 & 1124
FEBRUARY 11, 1981 1215 THROUGH 1218
1271 THROUGH 1274

R. 51-1/2 E.

R. 52 E.

LOCATED WITHIN SECTIONS 13, 14, 23, 24, 25 & 26,
T. 22 N., R. 51 E., SECTIONS 25 & 36, T. 22 N.,
R. 51-1/2 E.

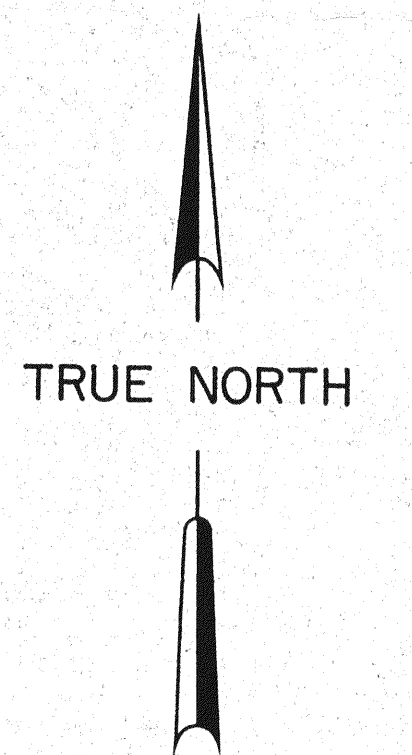

SCALE: 1" = 500'

FILED AT THE REQUEST OF
INBERG SURVEYING CO
on March 11, 1981
at 5:19 p.m. post 11 A.M.
by WILL A. DePAOLI, RECORDS
OF EUREKA COUNTY, NEVADA
Recorder
File No. 79895-1680

MAP OF THE
M. H. LODE MINING CLAIMS
MOUNT HOPE MINING DISTRICT
EUREKA COUNTY, NEVADA

LOCATED BY RICHARD D. INBERG
AGENT FOR EXXON CORPORATION
EXXON MINERALS COMPANY
P.O. BOX 120
DENVER, COLORADO 80201

SHEET 3 OF 7 SHEETS

79895

JOB NO. 1709-81

2/26/81

NOTE:



- INDICATES 4"X4"X4-1/2' WOODEN POST OR CUT TREE MONUMENT
- ⊠ INDICATES 4"X4"X4-1/2' WOODEN POST OR CUT TREE LOCATION MONUMENT
- ⊠ LOCATION MONUMENT LOCATED 10' FROM END LINE OF CLAIM UNLESS NOTED
- ⊠ INDICATES SECTION CORNER

SECTION LINES SHOWN ARE PROJECTED

LOCATION DATES:

FEBRUARY 8, 1981 1276 THROUGH 1288 (EVEN NOS.)
1319 THROUGH 1332
1375 THROUGH 1376
FEBRUARY 9, 1981 1363 THROUGH 1374
1407 THROUGH 1420

LOCATED WITHIN SECTIONS 25 & 36, T. 22 N., R. 51-1/2 E.,
& SECTIONS 29, 30, 31 & 32, T. 22 N., R. 52 E.

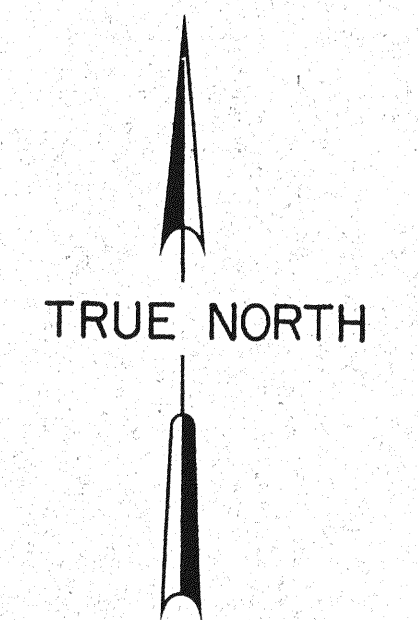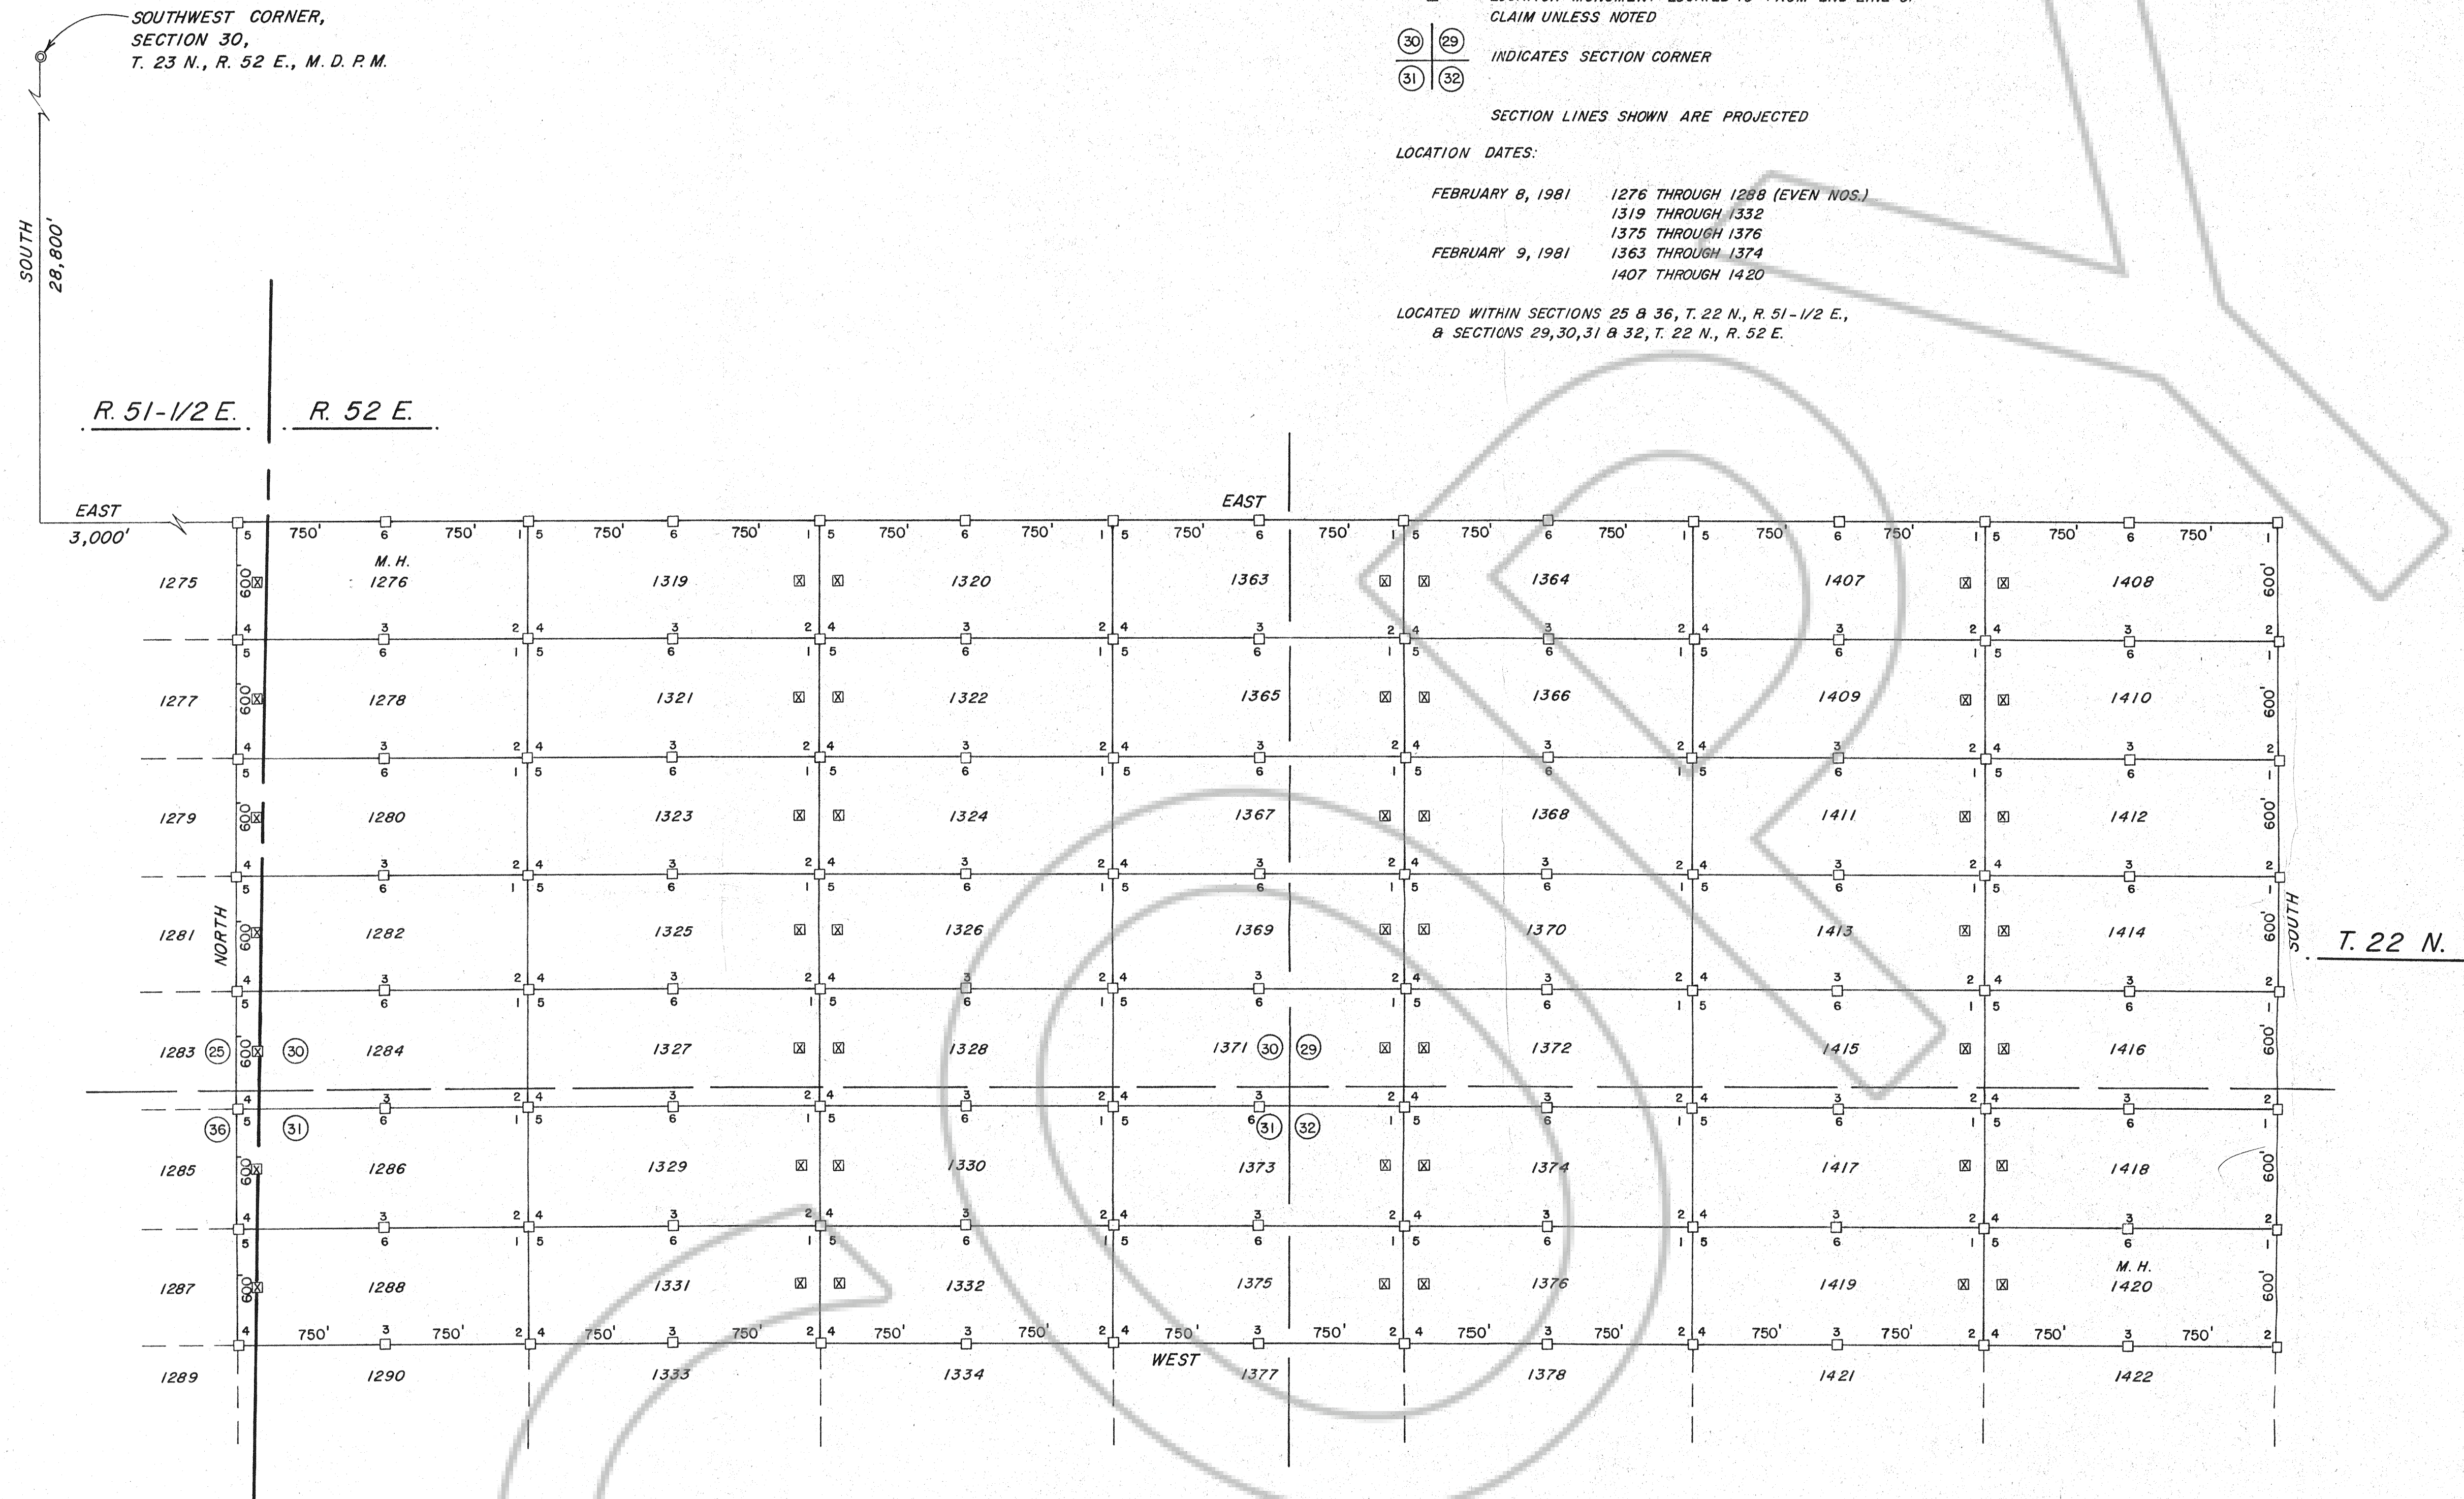

SCALE: 1" = 500'

THE SURVEY OF
INBERG SURVEYING CO.
on March 11, 1981
at 5:30 min. past 11 A.M.
in EUREKA COUNTY, NEVADA
WILL A. DI PAOLI
Recorder
File No. 79895

49 X 15 = 735
MAP OF THE
M. H. LODE MINING CLAIMS
MOUNT HOPE MINING DISTRICT
EUREKA COUNTY, NEVADA


LOCATED BY RICHARD D. INBERG
AGENT FOR EXXON CORPORATION
EXXON MINERALS COMPANY
P.O. BOX 120
DENVER, COLORADO 80201

SHEET 4 OF 7 SHEETS

79895

JOB NO. 1709-81

2/26/81

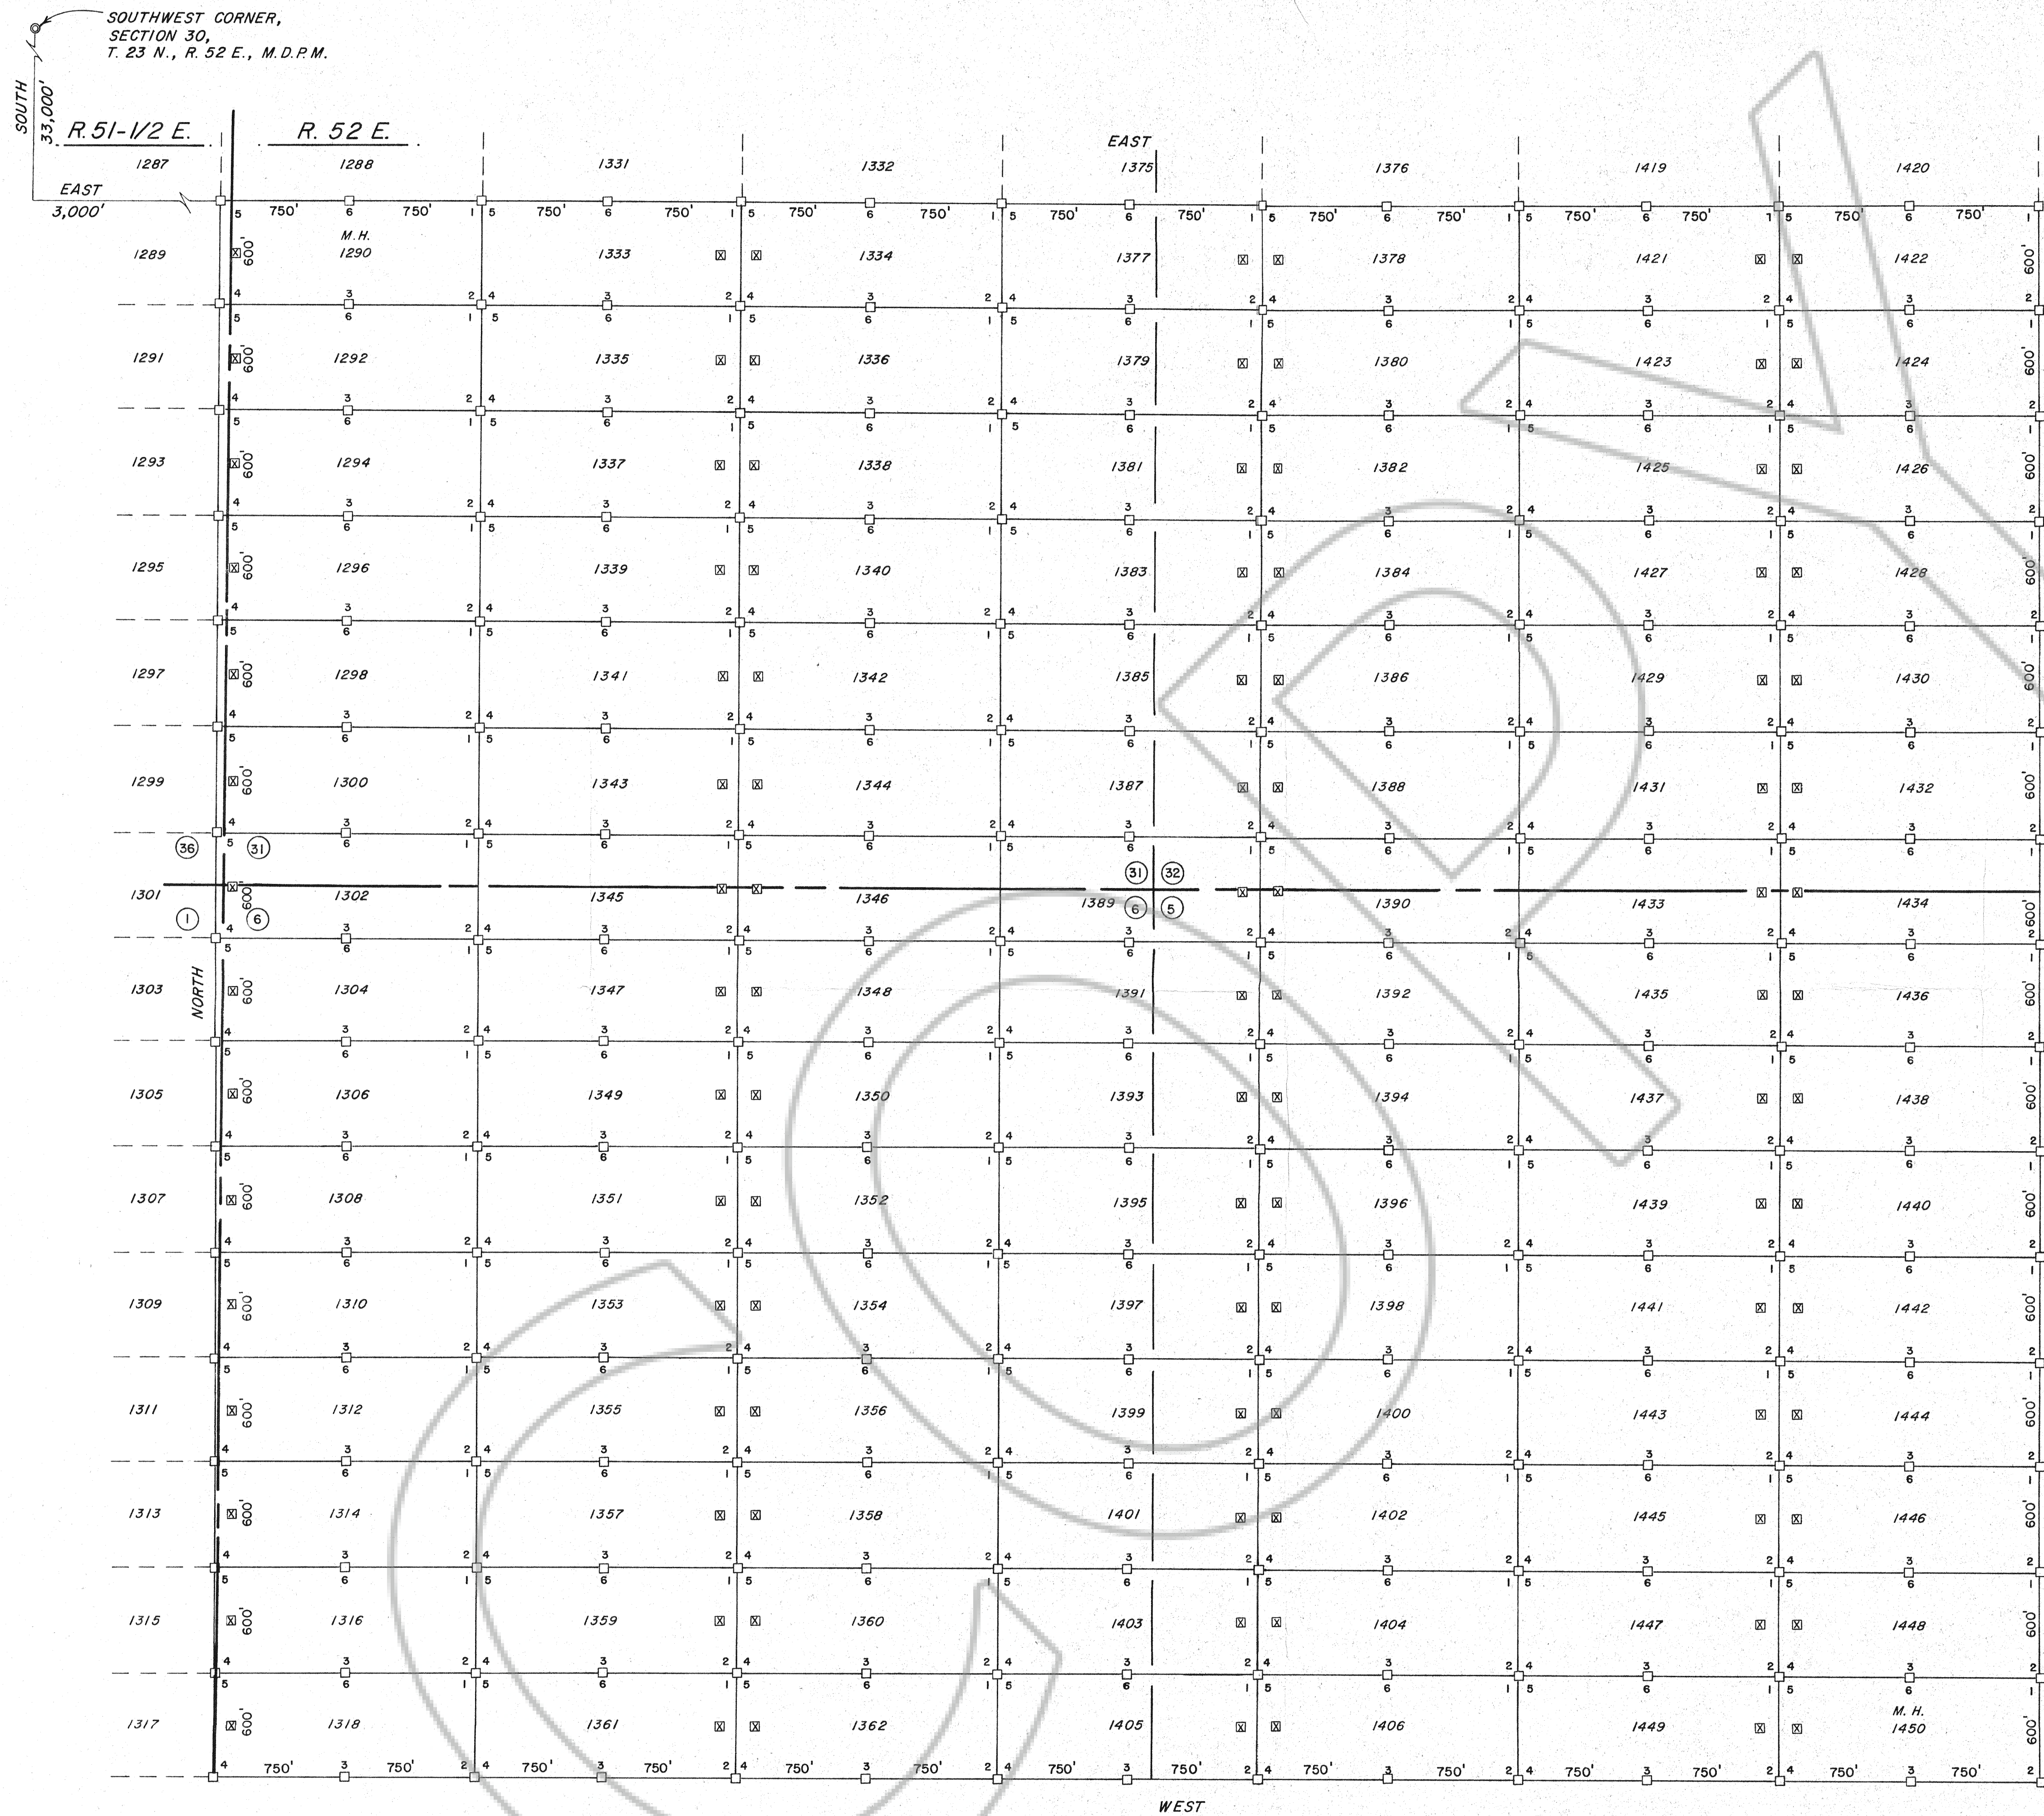

- NOTE:
- INDICATES 4"X4"X4-1/2' WOODEN POST OR CUT TREE MONUMENT
 - ⊠ INDICATES 4"X4"X4-1/2' WOODEN POST OR CUT TREE LOCATION MONUMENT
 - ⊞ LOCATION MONUMENT LOCATED 10' FROM END LINE OF CLAIM UNLESS NOTED
 - ③② INDICATES SECTION CORNER

SECTION LINES SHOWN ARE PROJECTED

LOCATION DATES:


FEBRUARY 8, 1981 1290 THROUGH 1296 (EVEN NOS.)
1333 THROUGH 1362
1377 & 1378

FEBRUARY 9, 1981 1298 THROUGH 1318 (EVEN NOS.)
1379 THROUGH 1390
1421 THROUGH 1432

FEBRUARY 10, 1981 1391 THROUGH 1406
1433 THROUGH 1450

LOCATED WITHIN SECTION 1, T. 21-1/2 N., R. 51-1/2 E., SECTION 36,
T. 22 N., R. 51-1/2 E., SECTIONS 5 & 6, T. 21-1/2 N., R. 52 E., &
SECTIONS 31 & 32, T. 22 N., R. 52 E.

T. 22 N.
T. 21-1/2 N.

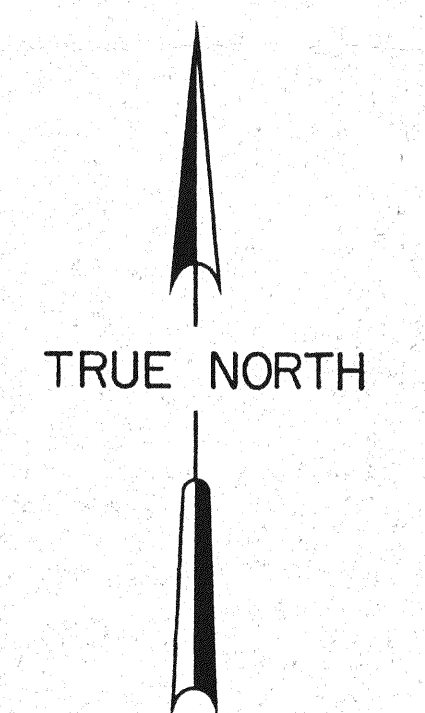

SCALE: 1" = 500'

Filed at the request of
INBERG SURVEYING CO
on March 11, 1981
at 5:30 p.m. past 11 A.M.
RECORDS
OF EUREKA COUNTY, NEVADA
WILL A. D'ARNO
Recorder
File No. 79895 Fee \$ 1575.00

105 115 = 1575.00


**MAP OF THE
M. H. LODE MINING CLAIMS
MOUNT HOPE MINING DISTRICT
EUREKA COUNTY, NEVADA**

LOCATED BY RICHARD D. INBERG
AGENT FOR EXXON CORPORATION
EXXON MINERALS COMPANY
P.O. BOX 120
DENVER, COLORADO 80201

79895

SHEET 5 OF 7 SHEETS

R. 52 E.

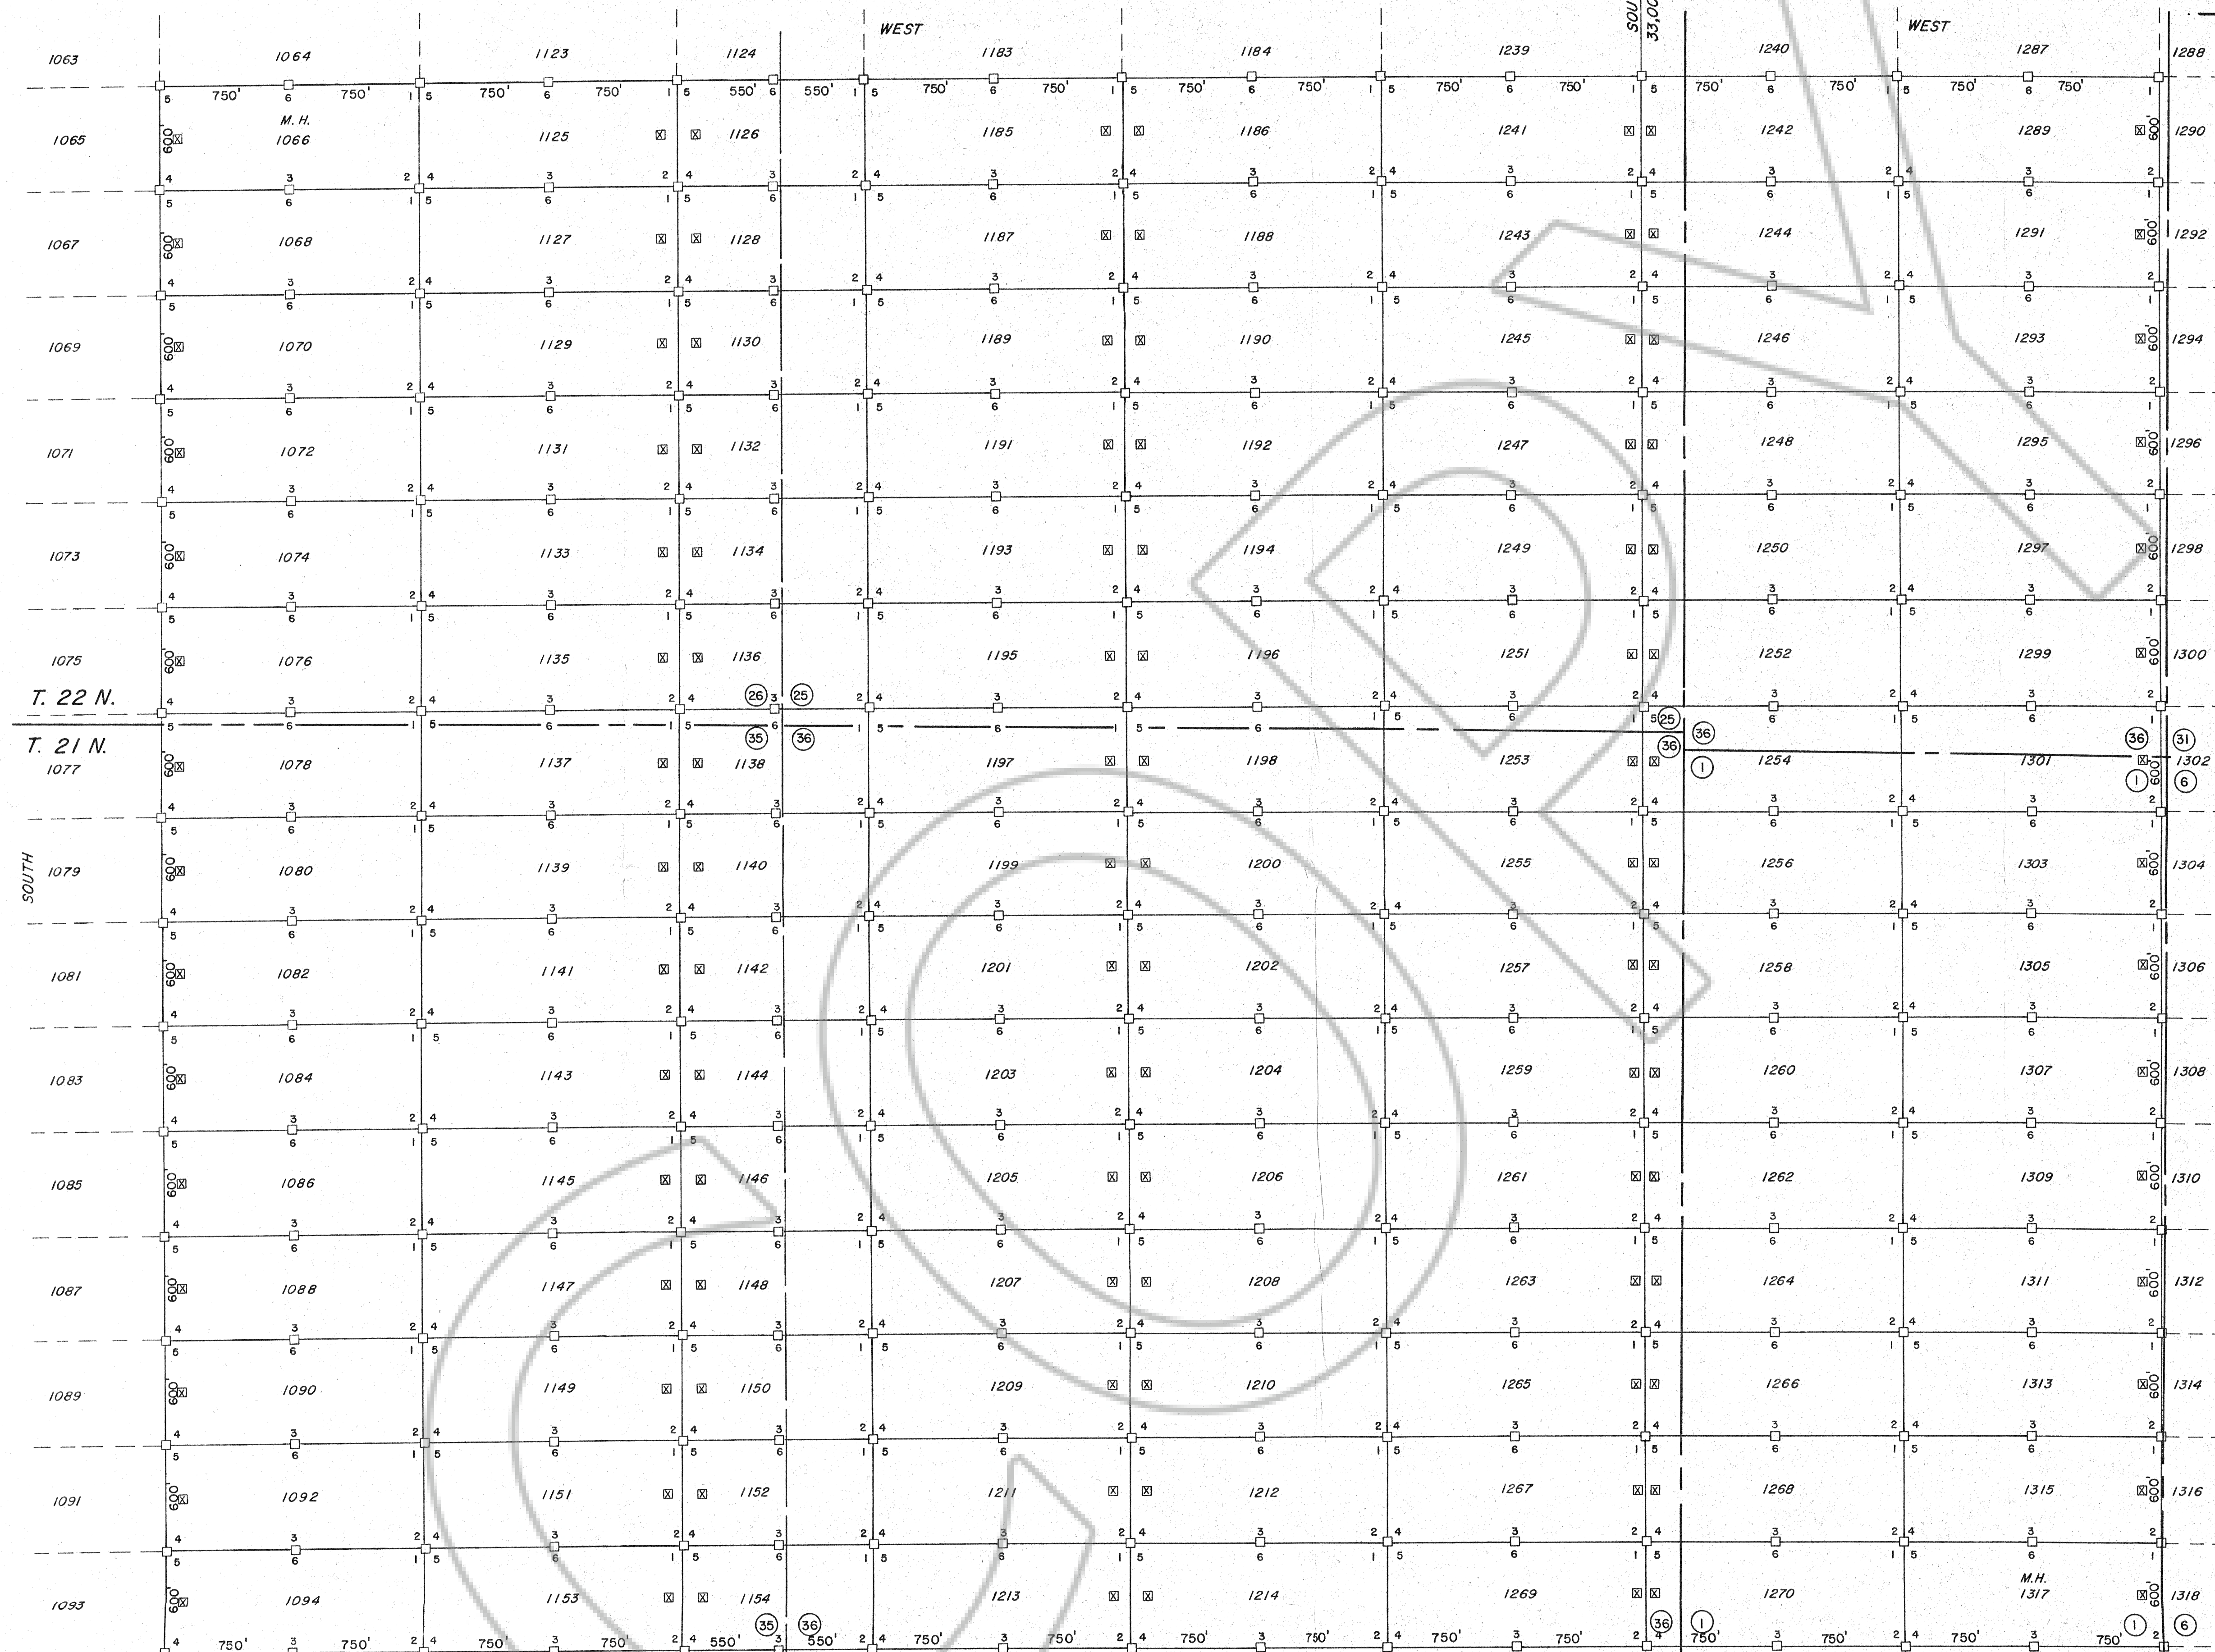

NOTE:

- ☐ INDICATES 4"x4"x4'-1/2' WOODEN POST
OR CUT TREE MONUMENT
- ☒ INDICATES 4"x4"x4'-1/2' WOODEN POST
OR CUT TREE LOCATION MONUMENT
- ☒ LOCATION MONUMENT LOCATED 10' FROM
END LINE OF CLAIM UNLESS NOTED


 INDICATES SECTION CORNER


SECTION LINES SHOWN ARE PROJECTED
LOCATION DATES:

FEBRUARY 6, 1981 1066 THROUGH 1094 (EVEN NOS.)
FEBRUARY 8, 1981 1185 THROUGH 1214
1289 THROUGH 1295 (ODD NOS.)
FEBRUARY 9, 1981 1241 THROUGH 1270
1297 THROUGH 1317 (ODD NOS.)
FEBRUARY 10, 1981 1125 THROUGH 1154

LOCATED WITHIN SECTIONS 35 & 36, T. 21 N., R. 51 E.,
SECTIONS 25 & 26, T. 22 N., R. 51 E., SECTION 1,
T. 21-1/2 N., R. 51-1/2 E., & SECTION 36, T. 22 N.,
R. 51-1/2 E.

T. 22 N.

T. 21-1/2 N.

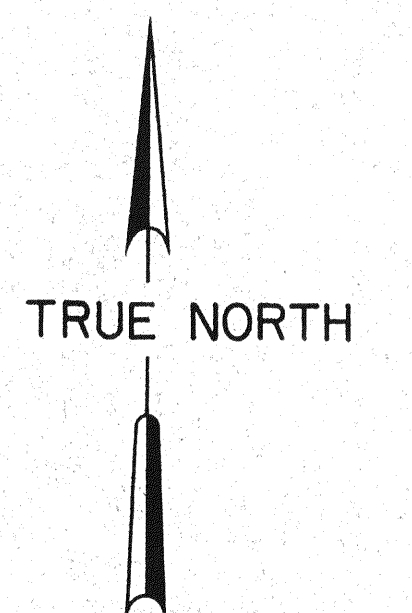

SCALE: 1" = 500'

Filed
~~RECORDED~~ AT THE REQUEST OF
INBERG SURVEYING CO
 on March 11 1981
 at 5.9 mins. past 11 A. M.
 in ~~the~~ ~~of~~ ~~the~~
~~RECORDED~~ RECORDS
 OF EUREKA COUNTY, NEVADA
 WILL A. DePAOLI
 Recorder
 No. 79895 Fee \$ 13.00

$$120 \times 15 = 1800$$

MAP OF THE
M. H. LODE MINING CLAIMS
MOUNT HOPE MINING DISTRICT
EUREKA COUNTY, NEVADA

LOCATED BY RICHARD D. INBERG
AGENT FOR EXXON CORPORATION
EXXON MINERALS COMPANY
P.O. BOX 120
DENVER, COLORADO 80201

JOB NO. 1709-81


/26/81

SHEET 6 OF 7 SHEETS

79895

R. 51 E.

SOUTHWEST CORNER,
SECTION 30,
T. 23 N., R. 52 E., M.D.P.M.

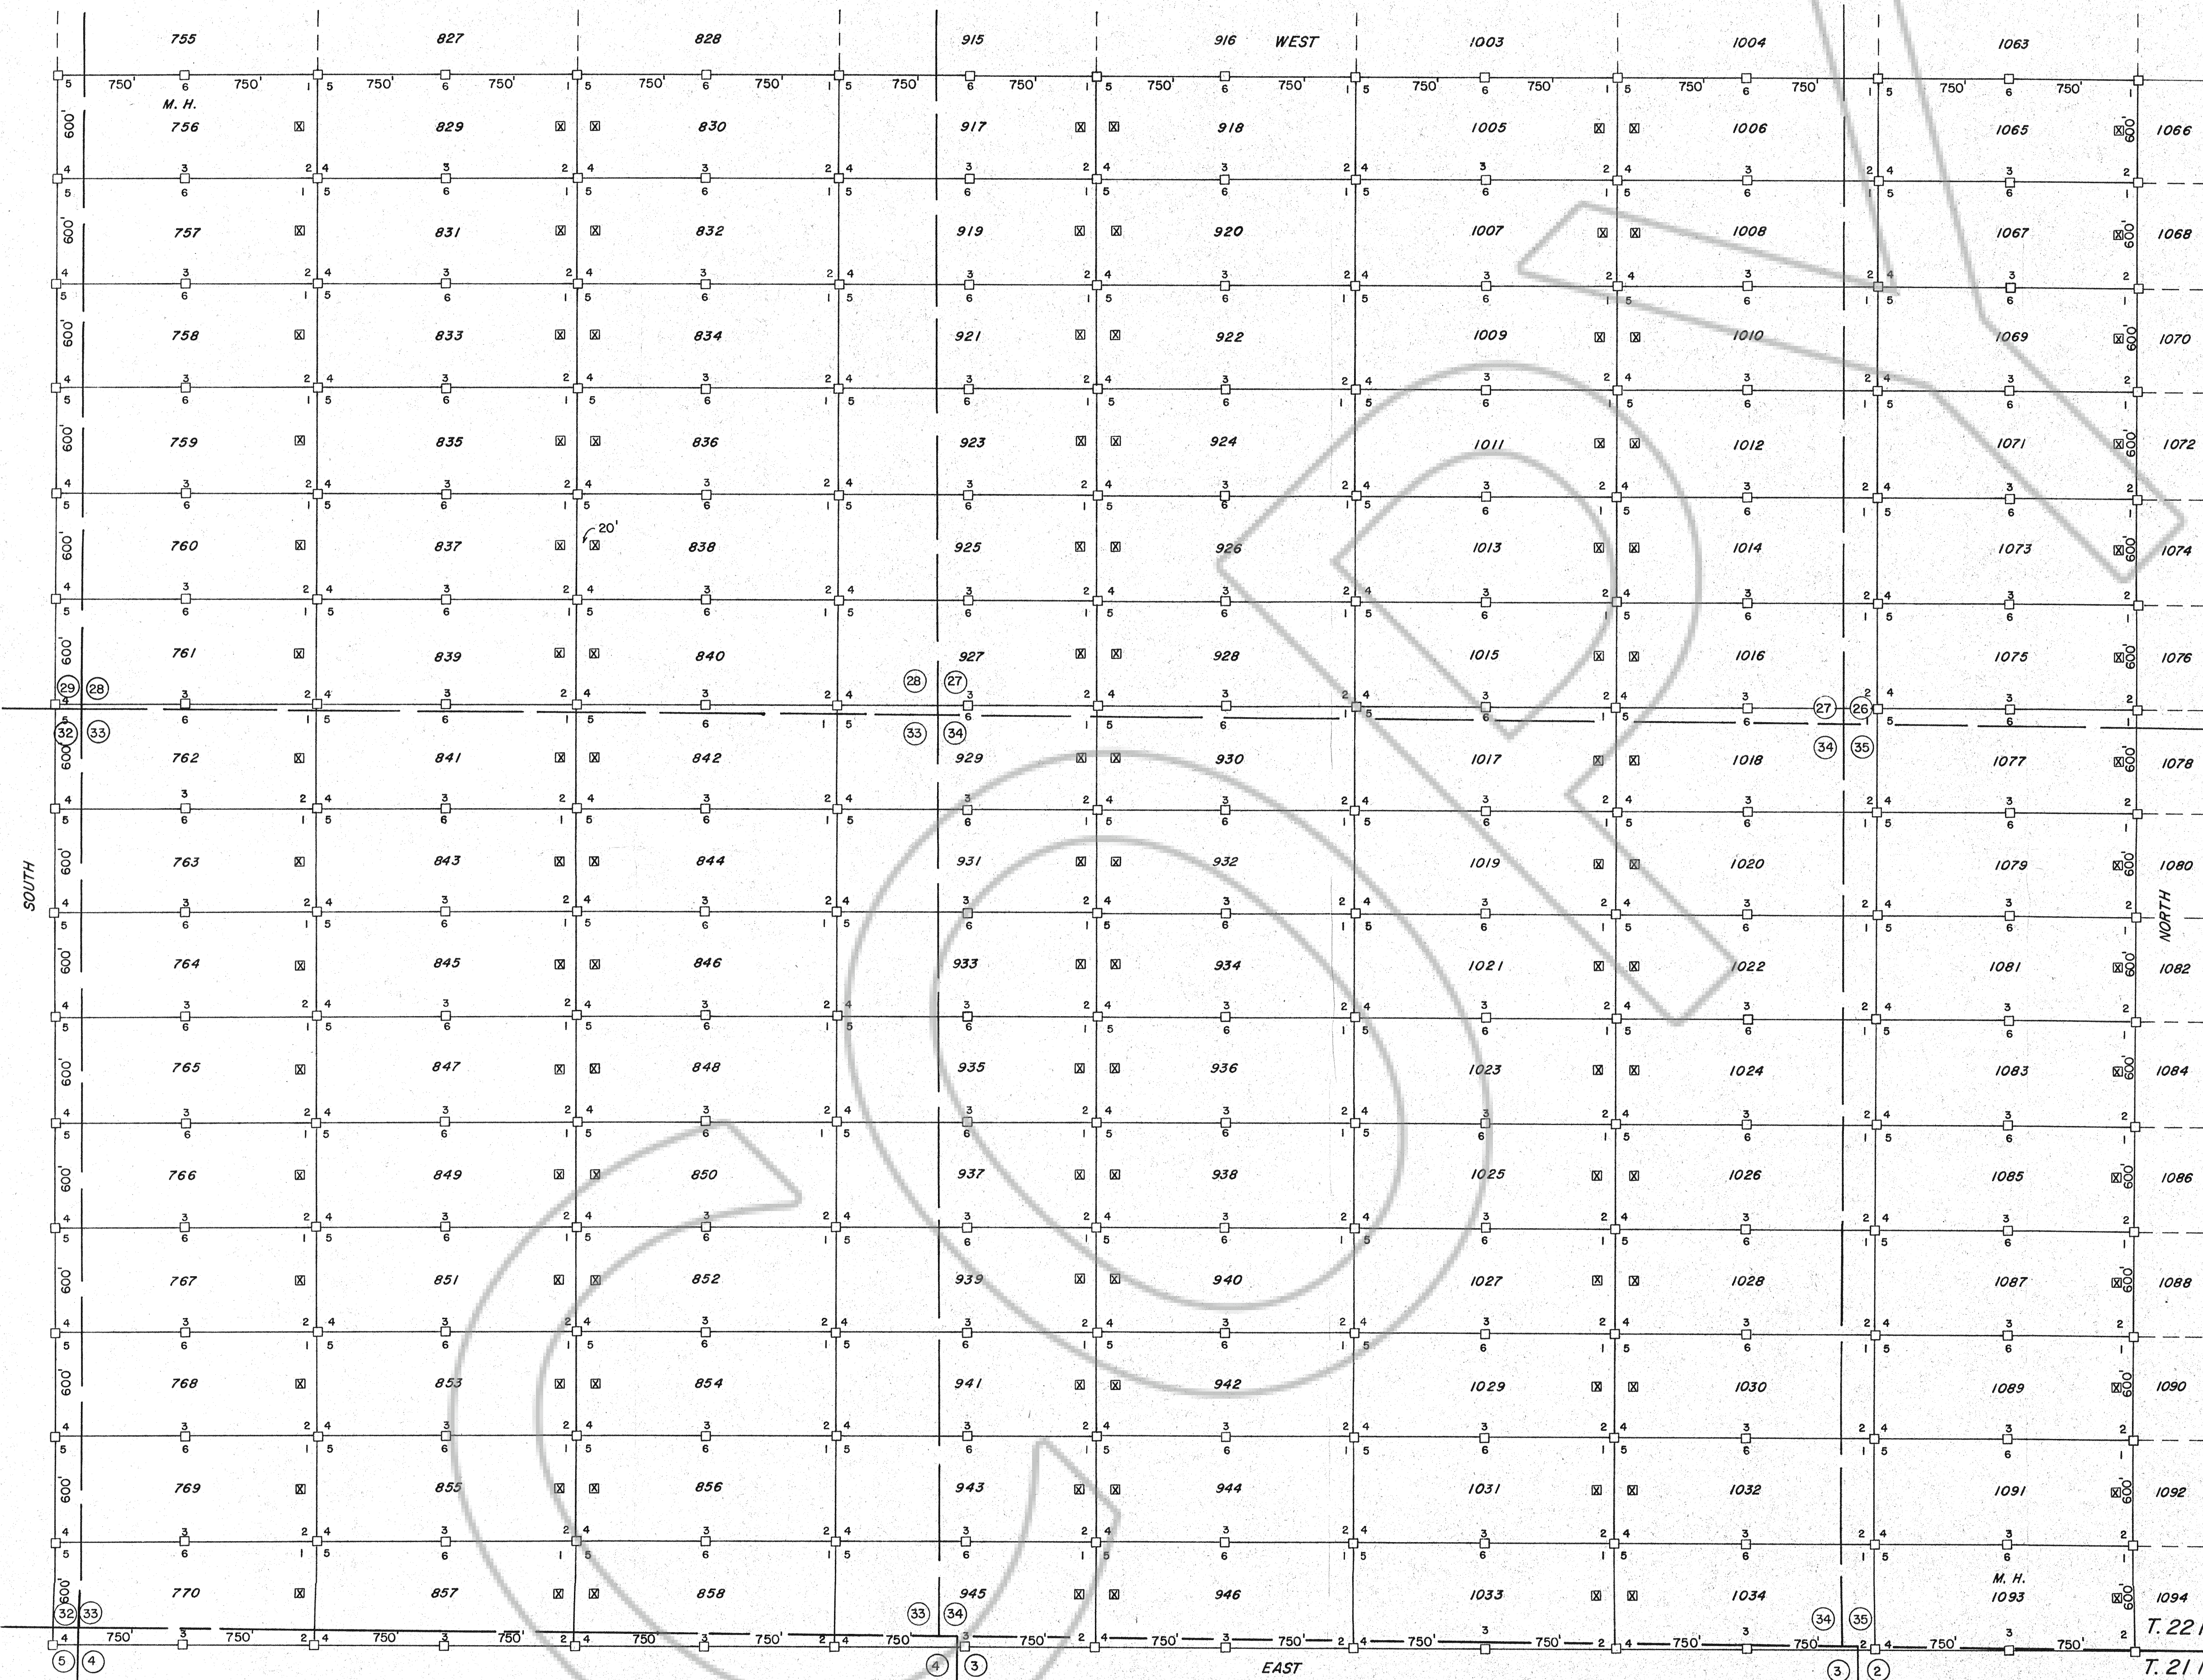

NOTE:


- INDICATES 4" X 4" X 4-1/2' WOODEN POST OR CUT TREE MONUMENT
- ⊠ INDICATES 4" X 4" X 4-1/2' WOODEN POST OR CUT TREE LOCATION MONUMENT
- ⊞ LOCATION MONUMENT LOCATED 10' FROM END LINE OF CLAIM UNLESS NOTED

(27) (26)
(34) (35)
INDICATES SECTION CORNER

SECTION LINES SHOWN ARE PROJECTED

LOCATION DATES:

FEBRUARY 5, 1981 829 THROUGH 838
917 THROUGH 928
1005 THROUGH 1012
FEBRUARY 6, 1981 929 THROUGH 946, 756
1013 THROUGH 1034
1065 THROUGH 1093 (ODD NOS.)
FEBRUARY 15, 1981 762 THROUGH 770
839 THROUGH 858
FEBRUARY 16, 1981 757 THROUGH 761
LOCATED WITHIN SECTIONS 26, 27, 28, 29, 32, 33, 34 & 35,
T. 22 N., R. 51 E., & SECTIONS 2, 3, 4 & 5, T. 21 N., R. 51 E.

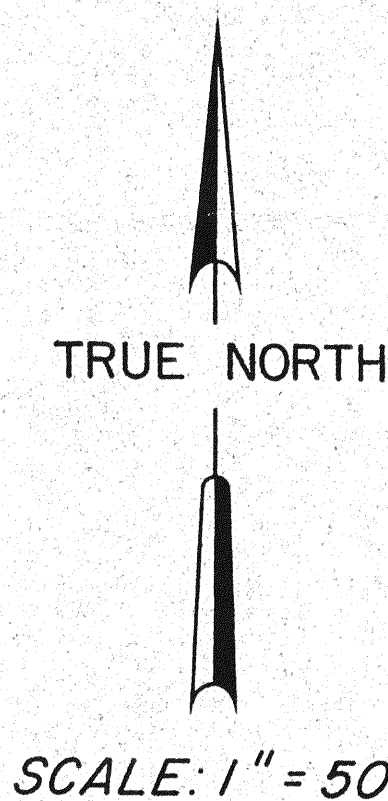

SCALE: 1" = 500'

Filed
AT THE REQUEST OF
INBERG SURVEYING CO.
on March 11, 1981
at 5:59 mins. past 11 A.M.
RECORDS
OF EUREKA COUNTY, NEVADA
WILL A. DePAOLI
Recorder
File No. 79895-1800

MAP OF THE
M. H. LOPE MINING CLAIMS
MOUNT HOPE MINING DISTRICT
EUREKA COUNTY, NEVADA

LOCATED BY RICHARD D. INBERG
AGENT FOR EXXON CORPORATION
EXXON MINERALS COMPANY

P.O. BOX 120
DENVER, COLORADO 80201 DATE: 2/26/81

SHEET 7 OF 7 SHEETS

79895