

AFFIDAVIT OF ANNUAL ASSESSMENT LABOR
AND VALUE OF LABOR AND IMPROVEMENTS

STATE OF COLORADO)
COUNTY OF JEFFERSON)

Before me personally appeared David C. Reid, agent for Tonkin Springs Gold Mining Company, who, being first duly sworn, stated that at least \$100 worth of work, labor improvements or geological or geochemical work, necessary to hold the same under mining laws of the United States and the State of Nevada for the assessment year ending September 1, 1985, has been performed upon, or for the benefit of each of the following named contiguous group of 4 unpatented lode mining claims:

Name of Claim	County Records		State Records
	Location Certificate Book	Page	Nevada BLM Serial No.
Rob #410	137	530	346730
Rob #411	137	531	346731
Rob #412	137	532	346732
Rob #413	137	533	346733

situated in the Roberts Mountain Mining District, in Sections 1 and 2, Township 23 $\frac{1}{2}$ North, Range 49 East of the Mount Diablo Prime Meridian, Eureka County, Nevada. See map, location of Mining Claims.

That such labor and improvements consisted of sampling, metallurgical test work, road work, supervision, geochemical analysis and assaying of samples. Additionally, a mining and heap leach project was constructed and put into operation on contiguous unpatented claims.

That such expenditures, work and improvements were made in excess of the amount required to hold the claims under mining laws of the United States and the State of Nevada by Silver State Mining Corporation and Tonkin Springs Gold Mining Company, Lessee whose current mailing address is 1600 Stout Street, suite 1600, Denver, Colorado 80202, and Precambrian Exploration, Inc., owner of said mining claims whose current mailing address is 4955 Iris Street, Wheatridge, Colorado 80033, and they were made for the assessment year beginning September 1, 1984 and ending on September 1, 1985 and were made during the period September 1, 1984 to August 31, 1985.

Dated, October 14th, 1985

Sammy J. Morin
Witness

David C. Reid
David C. Reid

Alyssa Shultz
Witness

Subscribed and sworn before me this


14th day of October, 1985

David M. Gladys
Notary Public

My Commission Expires Nov. 12, 1987




907 N. Radcliff Dr.
Lincoln, CO 80523

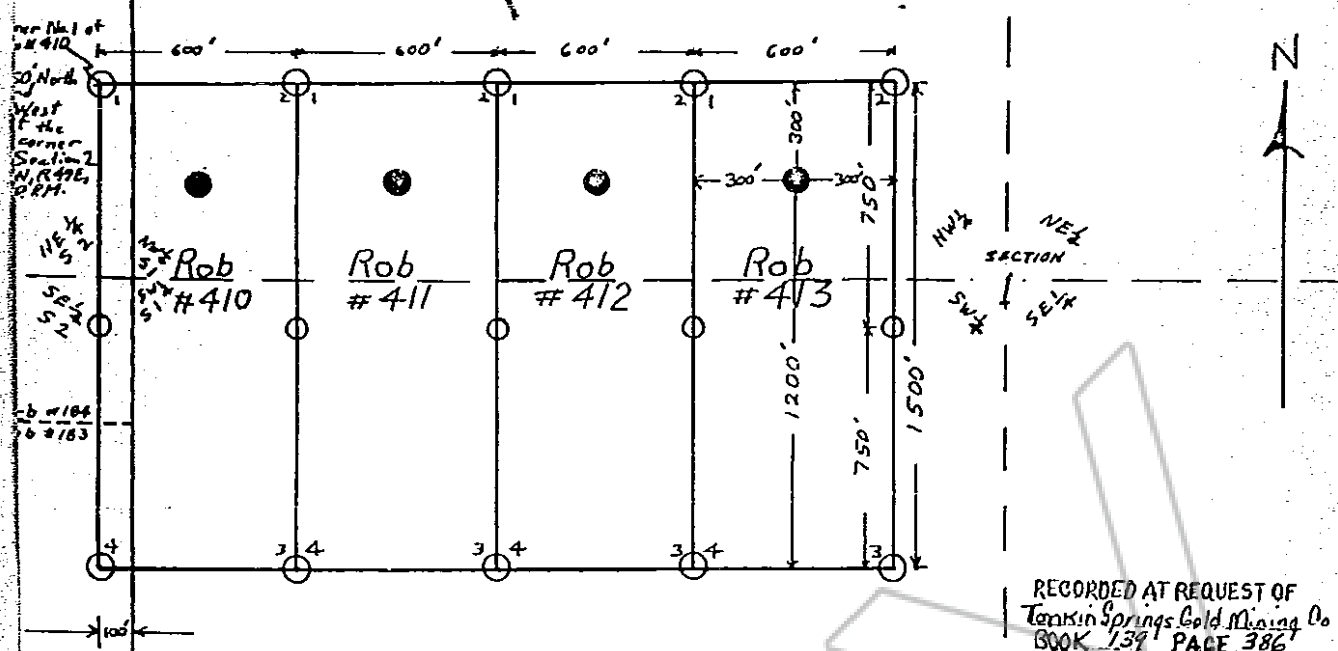

RECORDED AT REQUEST OF
Tonkin Springs Gold Mining Co.
BOOK 139 PAGE 386

85 OCT 21 AM: 14

OFFICIAL RECORDS
EUREKA COUNTY, NEVADA
M. N. REBALEATI, RECORDER
FILE NO. 100551
FEE \$ 5.00

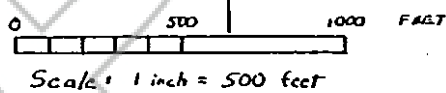

Scale: 1 inch = 500 feet

SECTION 2 SECTION 1
TOWNSHIP 23 1/2 NORTH
TOWNSHIP 23 NORTH

FILED AT THE REQUEST OF Thomas E. GOSICK
on August 15 1985 at 25 mins past 3 P. M.
RECORDS OF
EUREKA COUNTY, NEVADA
FILE NO. 100068
M. N. REBALEATI, RECORDER
Fee \$ 60.00

TONKIN SPRINGS GOLD MINING COMPANY

Map showing the location and
monuments of lode mining claims
Rob # 410, Rob # 411, Rob # 412, Rob # 413
Located and monumented June 20, 1985

- Discovery Monument
- Claim boundary (Rob 410 - 413)
- Corner post and Corner number
- Side Center post
- Monuments are 4-inch diameter posts
- Boundary of Rob claims located prior to 6-20-85
- Section line
- Quarter section line

Tie Point for the Rob claims
to the Public Land Survey
is
The SE corner of Section 2,
Township 23 North, Range 49 East
of the M. N. Diablo Principal Meridian

100068

Drawn by T. E. BOOK 139 PAGE 387