


RECORD OF SURVEY
A DEPENDENT SURVEY OF A PORTION OF SECTIONS 10, 11, 14 & 15 TOWNSHIP 19
NORTH, RANGE 53 EAST OF THE M.D.M., EUREKA COUNTY, NEVADA.

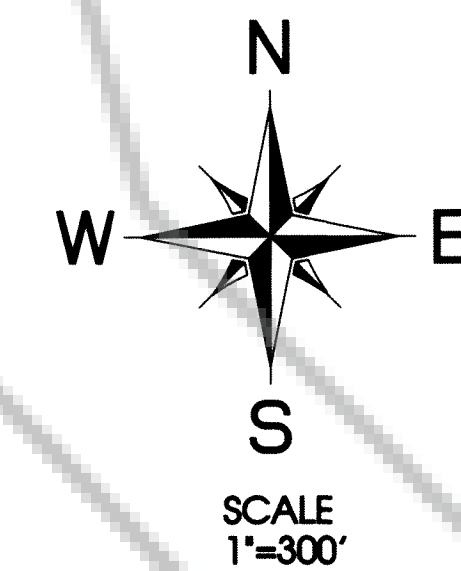

1/4 CORNER (a) MID SECTION LINE S89°53'25"E 5280.09'M 1/4 CORNER


SECTION 10

SECTION 11

SURVEYOR'S CERTIFICATE

I, DUSTIN JEAN, A PROFESSIONAL LAND SURVEYOR LICENSED IN THE STATE NEVADA, AS AN AGENT FOR MOHAVE ENGINEERING, INC., CERTIFY THAT:

- THIS PLAT REPRESENTS THE RESULTS OF A SURVEY CONDUCTED UNDER MY DIRECT SUPERVISION AT THE REQUEST OF RUBY HILL MINING COMPANY, LLC.
- THE LANDS SURVEYED ARE SITUATE WITHIN SECTIONS 10, 11, 14 & 15 TOWNSHIP 19 NORTH, RANGE 53 EAST, M.D.M., EUREKA COUNTY, NEVADA AND THE SURVEY WAS COMPLETED ON DECEMBER 1, 2016.
- THIS PLAT COMPLIES WITH APPLICABLE STATE STATUTES AND ANY LOCAL ORDINANCES IN EFFECT ON THE DATE THAT THE GOVERNING BODY GAVE ITS FINAL APPROVAL.
- THE MONUMENTS DEPICTED ON THE PLAT ARE OF THE CHARACTER SHOWN, OCCUPY THE POSITIONS INDICATED AND ARE OF SUFFICIENT DURABILITY.

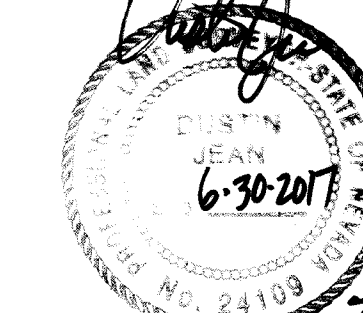

DUSTIN JEAN
PROFESSIONAL LAND SURVEYOR
NEVADA LICENSE NO. 24109

DOC # 0232722

03/23/2017 01:15 PM
Official Record
Recording Requested By:
JOSH RUCH
Eureka County - NV
Lisa Hoehne - Recorder
Fee \$21.00 Page 1 of 1
RPTT Recorded By: CH
Book- Page-




NOTES:

PERIOD OF SURVEY: NOVEMBER, 2016.

BASIS OF BEARING: THE NORTH HALF OF THE EAST
SECTION LINE OF SECTION 15, BEARING NORTH 00°00'18" WEST,
PER RECORD OF SURVEY MAP RECORDED ON JAN 15, 1997
AT FILE NO.165900.


LEGEND

- FOUND 3 1/4" BRASS CAP, USGLO DATED 1937
- (a) ● SET 5/8" REBAR W/YELLOW PLASTIC CAP, PLS 24109
- FOUND 5/8" REBAR W/ORANGE PLASTIC CAP, PLS 3535
- (b) ● FOUND T POST WITH ALUMINUM TAG STAMPED CTR 1/4 SEC 14
- ⊖ SET 5/8" REBAR W/YELLOW PLASTIC CAP, PLS 24109
- R INDICATES RECORD DATA PER RECORD OF SURVEY MAP RECORDED ON JAN 15, 1997 AT FILE NO.165900.
- M INDICATES MEASURED DATA THIS SURVEY.
- ⊙ INDICATES CALCULATED POSITION NOTHING FOUND OR SET.
- INDICATES MEASURED LINES.
- INDICATES MONUMENT LINE.
- ALL DISTANCES AS SHOWN HEREON ARE MEASURED DISTANCES AND ARE EXPRESSED IN FEET AND DECIMAL PLACES THEREOF.

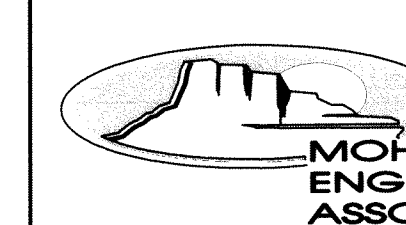

PHYSICAL: 2153 E. GORDON DRIVE, STE 1
MAIL: P.O. BOX 6547 - KINGMAN, AZ 86402
P: 928.753.2527 F: 928.753.9118
mohave-engineering.com

PREPARED FOR: RUBY HILL MINING COMPANY, LLC
PO BOX 676
INTERSECTION US 50 & 278 EUREKA,
NV 89316
TEL: 1-775-401-6437

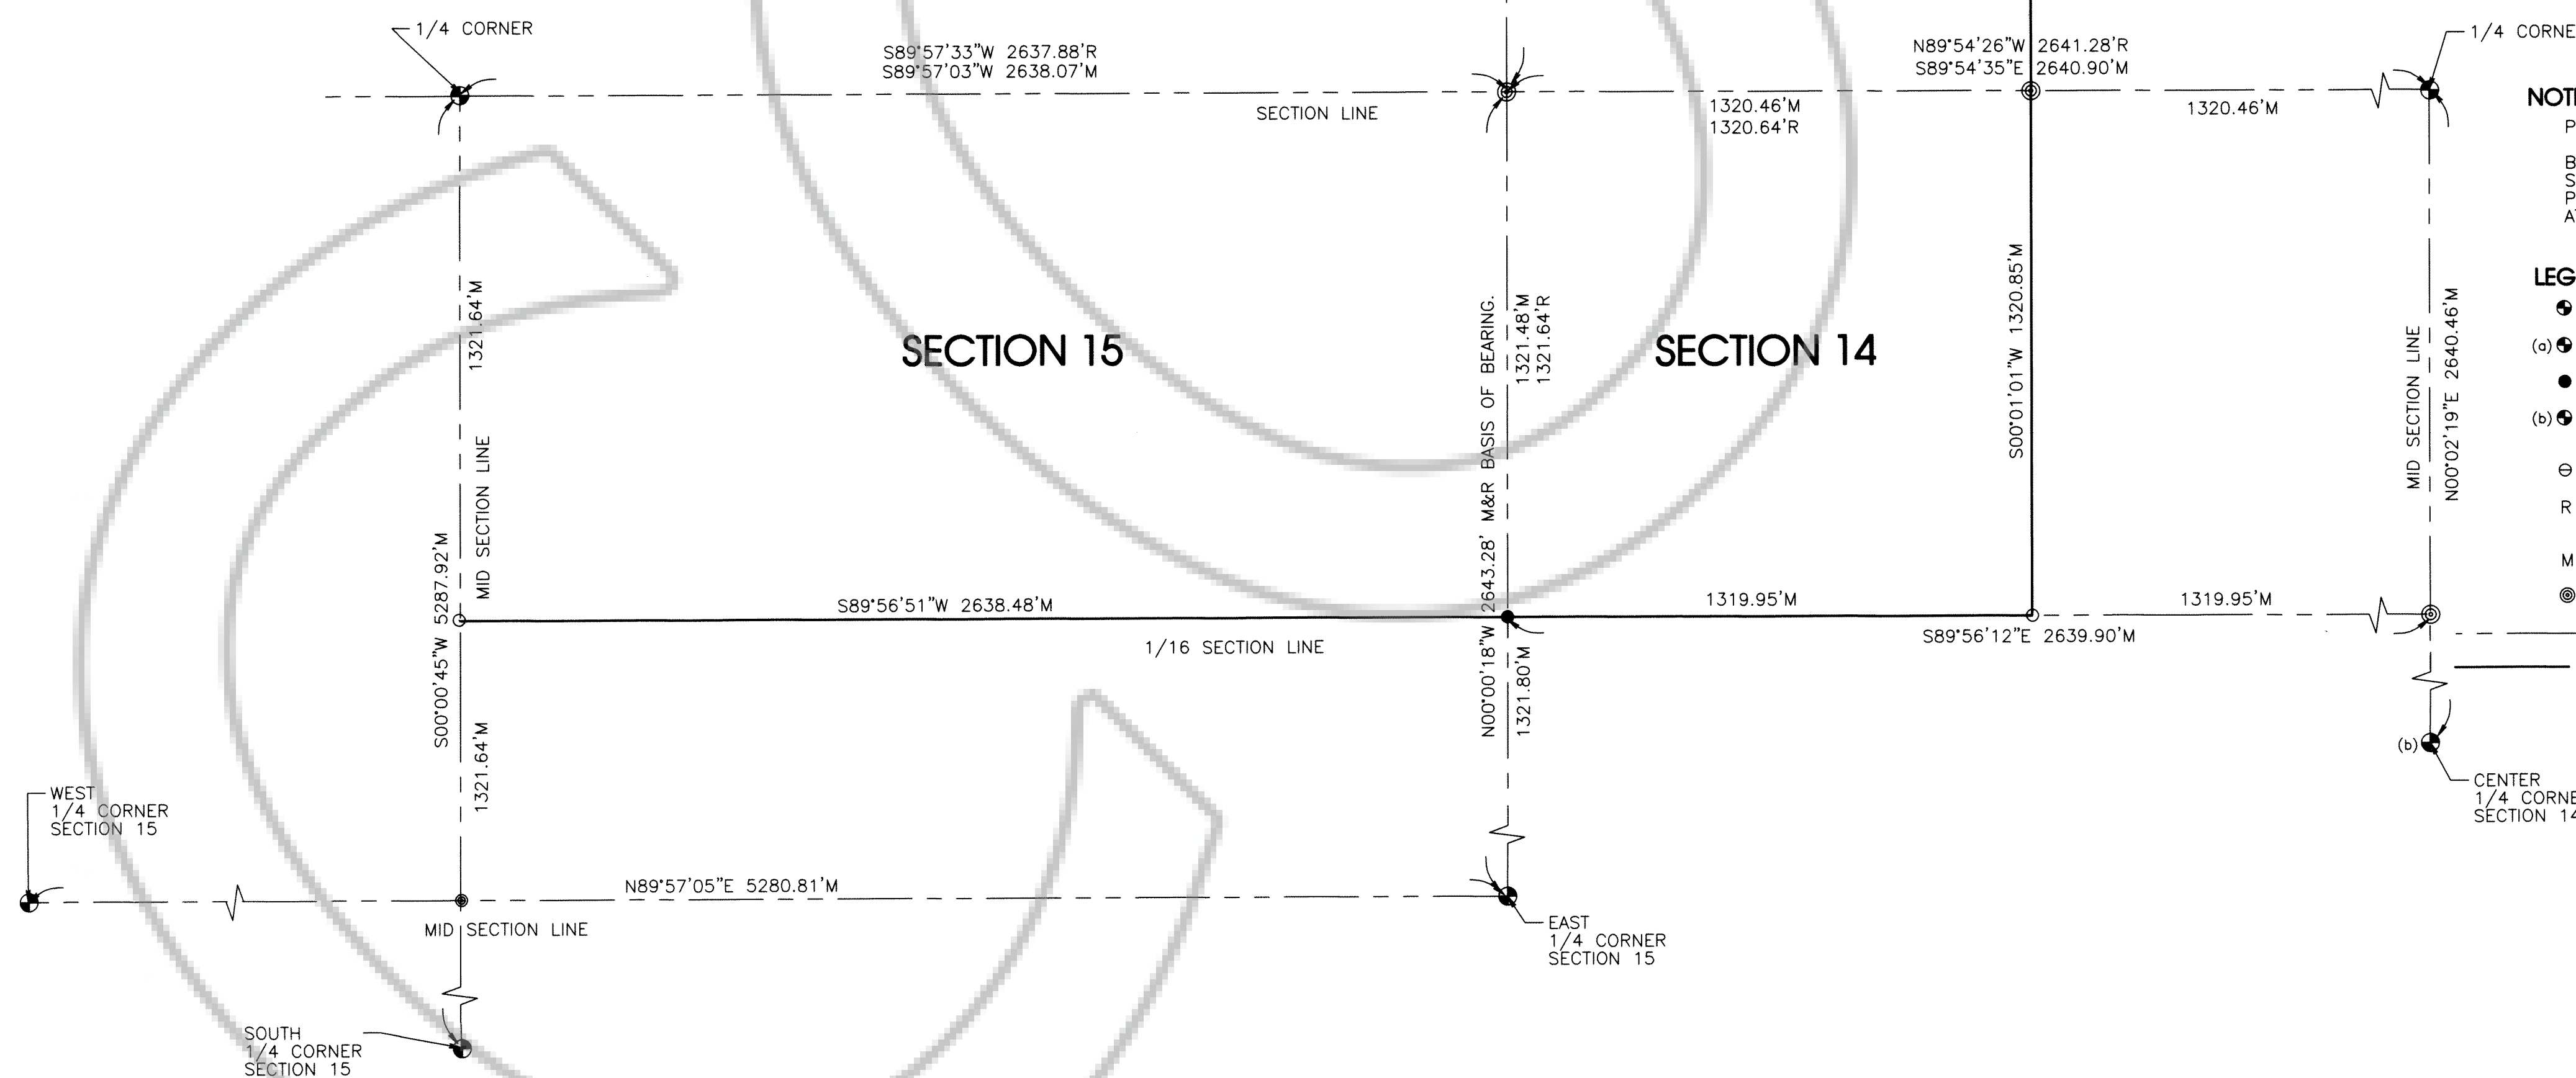

PLOT DATE: 3/8/2017 4:45PM FILE PATH: C:\Users\Dustin\Dropbox (MEA)\MEA\ Project Files\2016\16-123\16-123 RS\16-123 RS 2017-02-22.pro

PLOTTED BY: D.JEAN

DRAWN BY: D.JEAN

CHECKED BY: L.FOWLER

DATE: 03/07/2017

PROJECT NUMBER: 16-123

DRAWING NUMBER: 1 OF 1