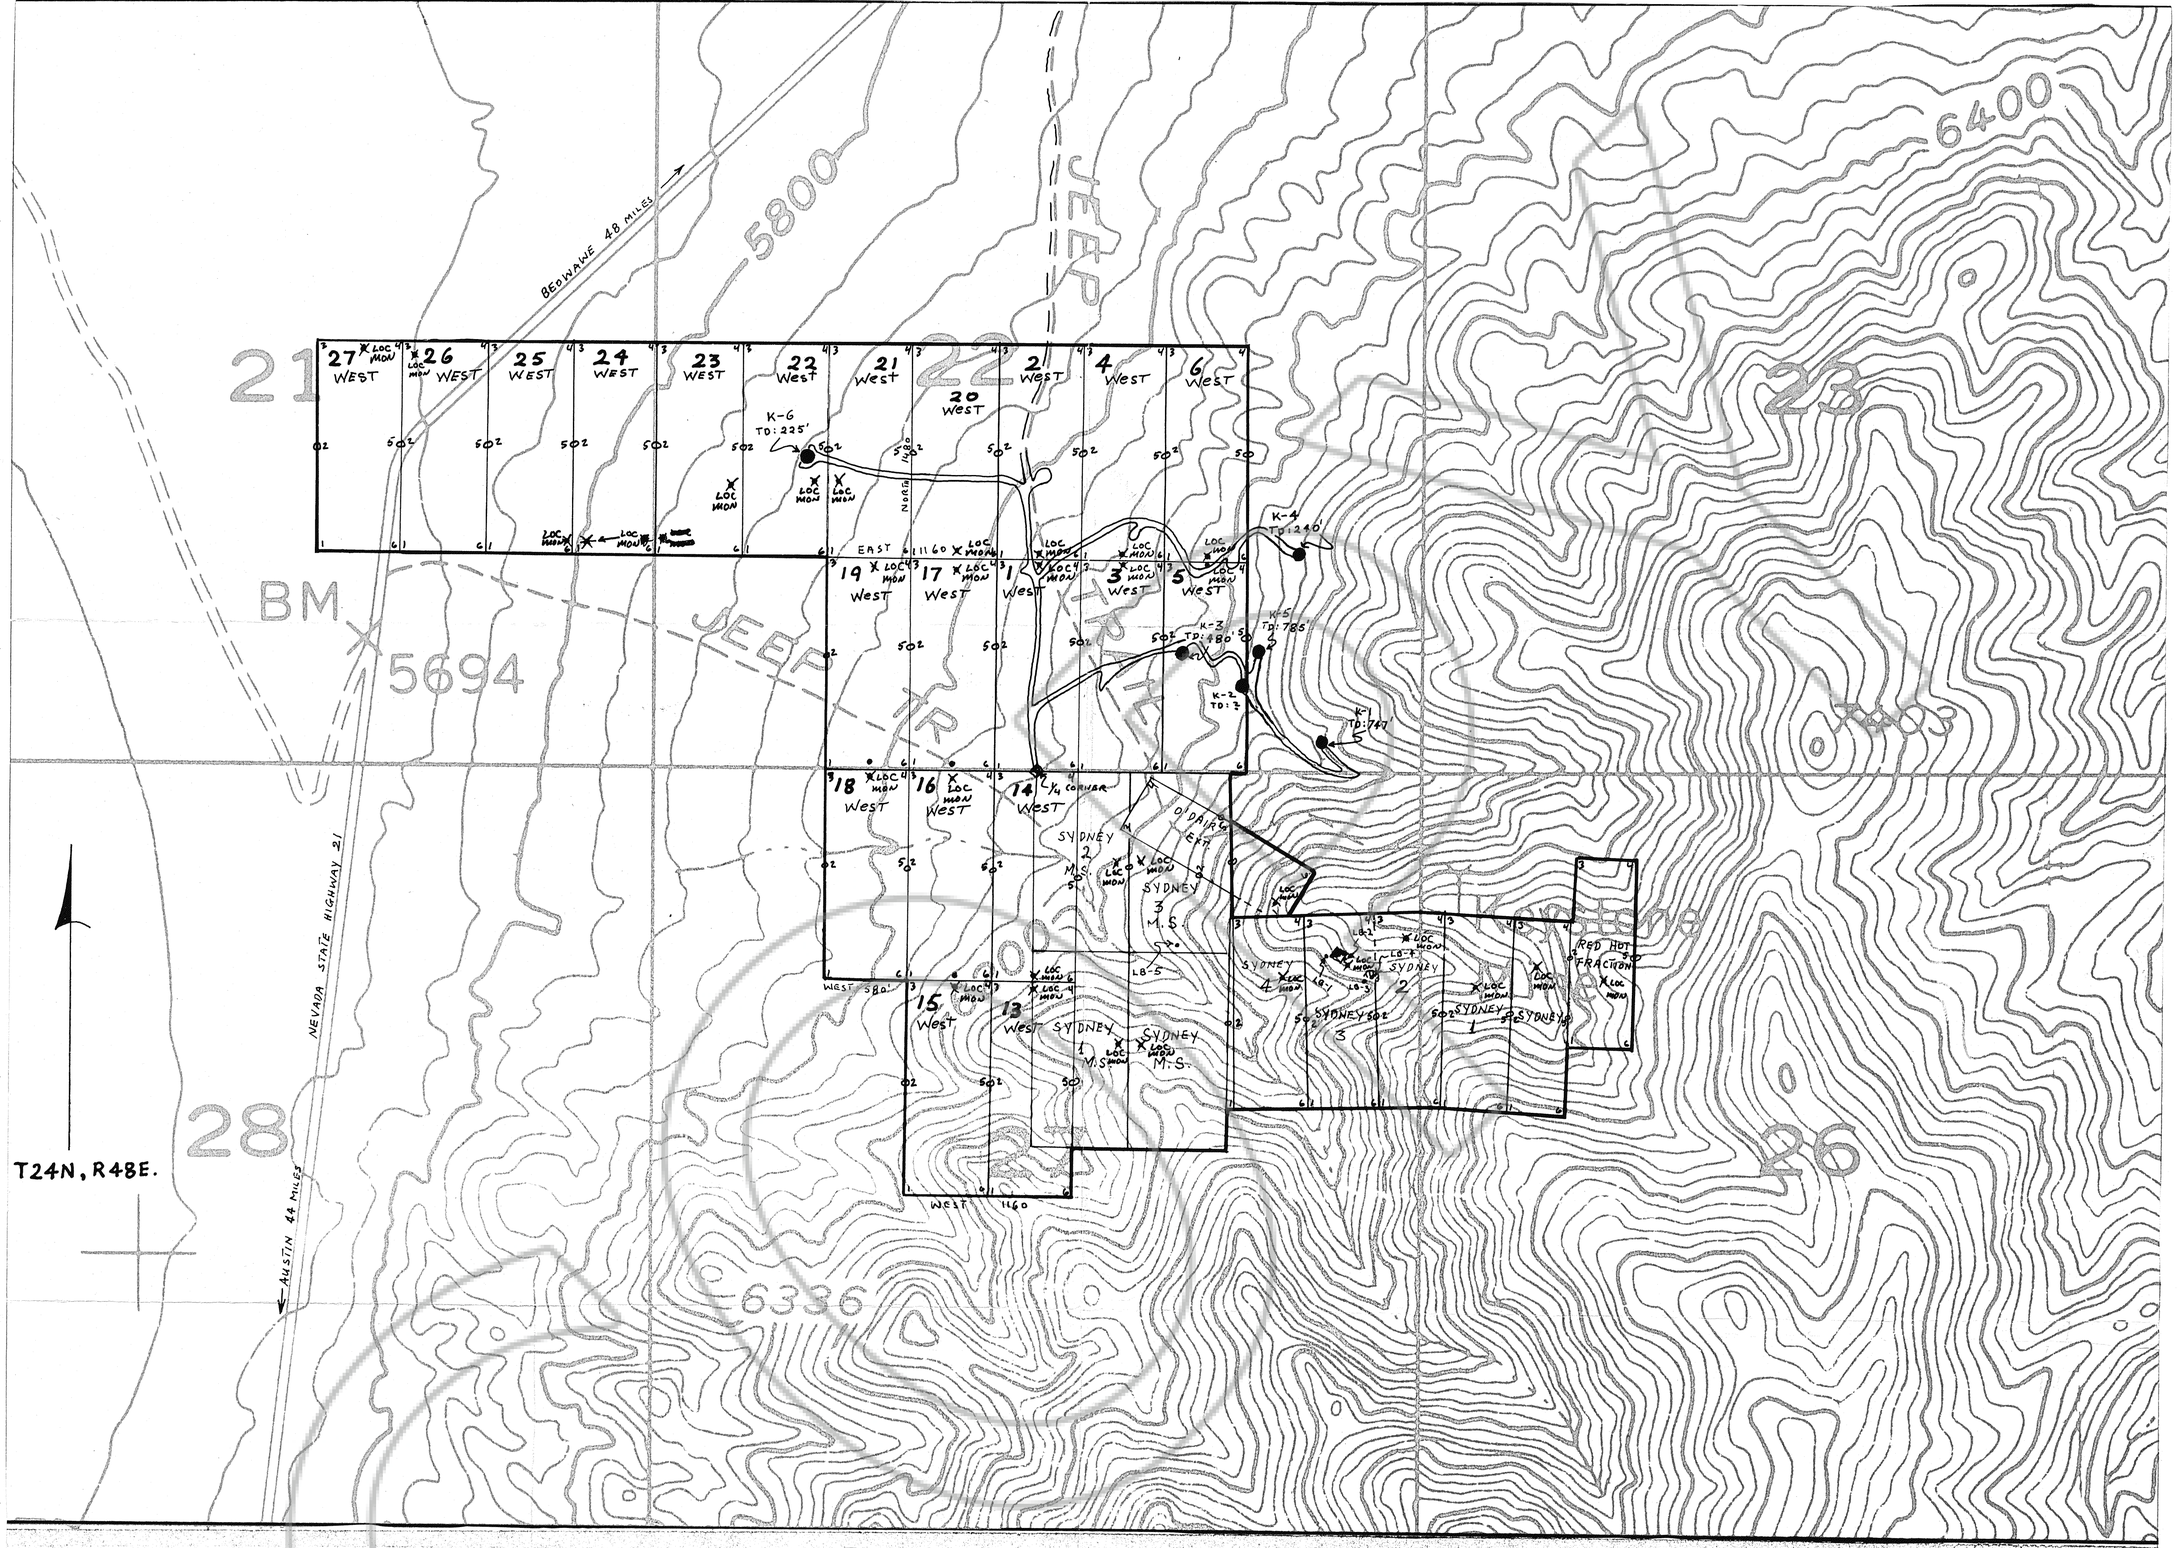

CLAIM MAP.

T24N, R48E, SECS. 21, 22, 26, 27.
NEVADA.

1" = 600'
scale

LAMB & BROUSSEAU,

KEYSTONE PROPERTY,

ROBERTS MINING DISTRICT,
EUREKA COUNTY, NEVADA.

LAMB & BROUSSEAU
P. O. BOX 143
VALLEJO, CALIFORNIA 94590

EXPLANATION

- K-6 TD: 225' — ROTARY DRILL HOLE LOCATION & DEPTH of HOLE
- LB-5 — SAMPLE LOCATION (RESULTS IN TEXT)
- SHAFT
- SMALL PIT

Filed ~~RECORDED~~ AT THE REQUEST OF N. A. LAMB
on APRIL 19, 1972, at 10 mins. past 11 A. M.
Book ~~_____~~, RECORDS OF
EUREKA COUNTY, NEVADA Phillis A. Watson Recorder.
File No. 55937 Fee $ 3.00