Filed
~~RECORDED~~ AT THE REQUEST OF
John Damele
on September 1, 1972
at 40 mins. past 9 A.M.
in Book ~~OFFICIAL~~
~~RECORDS~~, page ~~RECORDS~~, RECORDS
OF EUREKA COUNTY, NEVADA
Gillis A. McLaslie
Recorder
File No. 56446 Fee $3.00

File # 56446
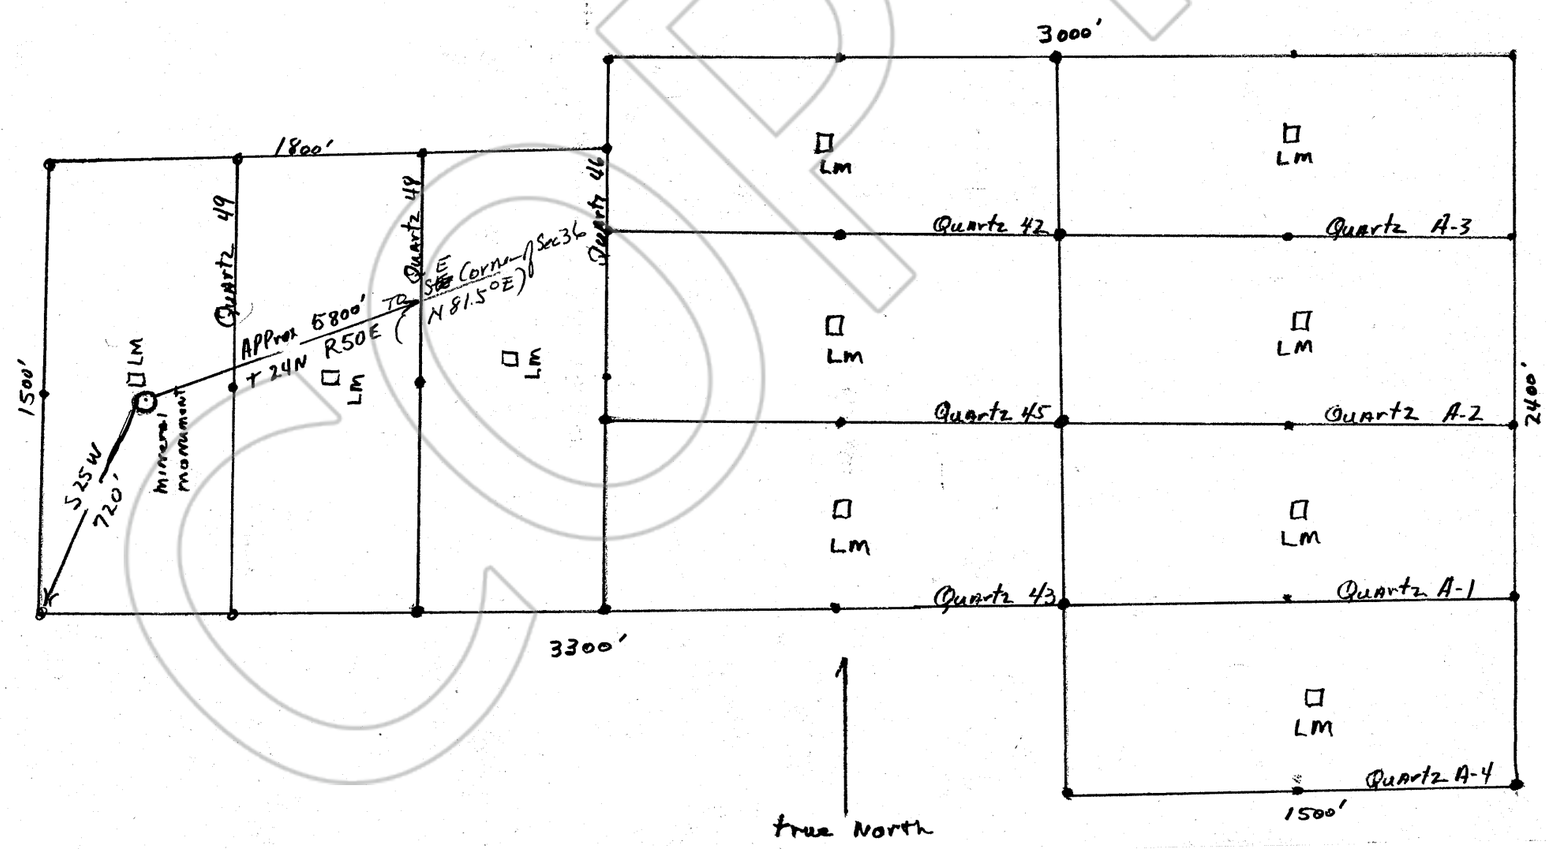
Claim Group 42 thru 49 Quartz — Leo J Damele John Damele
A2 thru A-4 — Leo G Damele Leroy Etchegaray
Lode Claims — Box 96 Eureka Nevada
Section 35-36 T 24N R50E — Unknown mining District
Section 1-2 T 23½ N R50E — Scale 1" = 500'
Quartz #49 Dated march 28 1966 #48 March 28 1966 #47 march 28-1966
#46 march 28-1966 #45 August 14 1967 #44 August 14-1967 #43 August 14-1967
#A-4 June 24-1970 #A3 June 24/1970 #A-2 June 17 1980 #A-1 June 17-1970