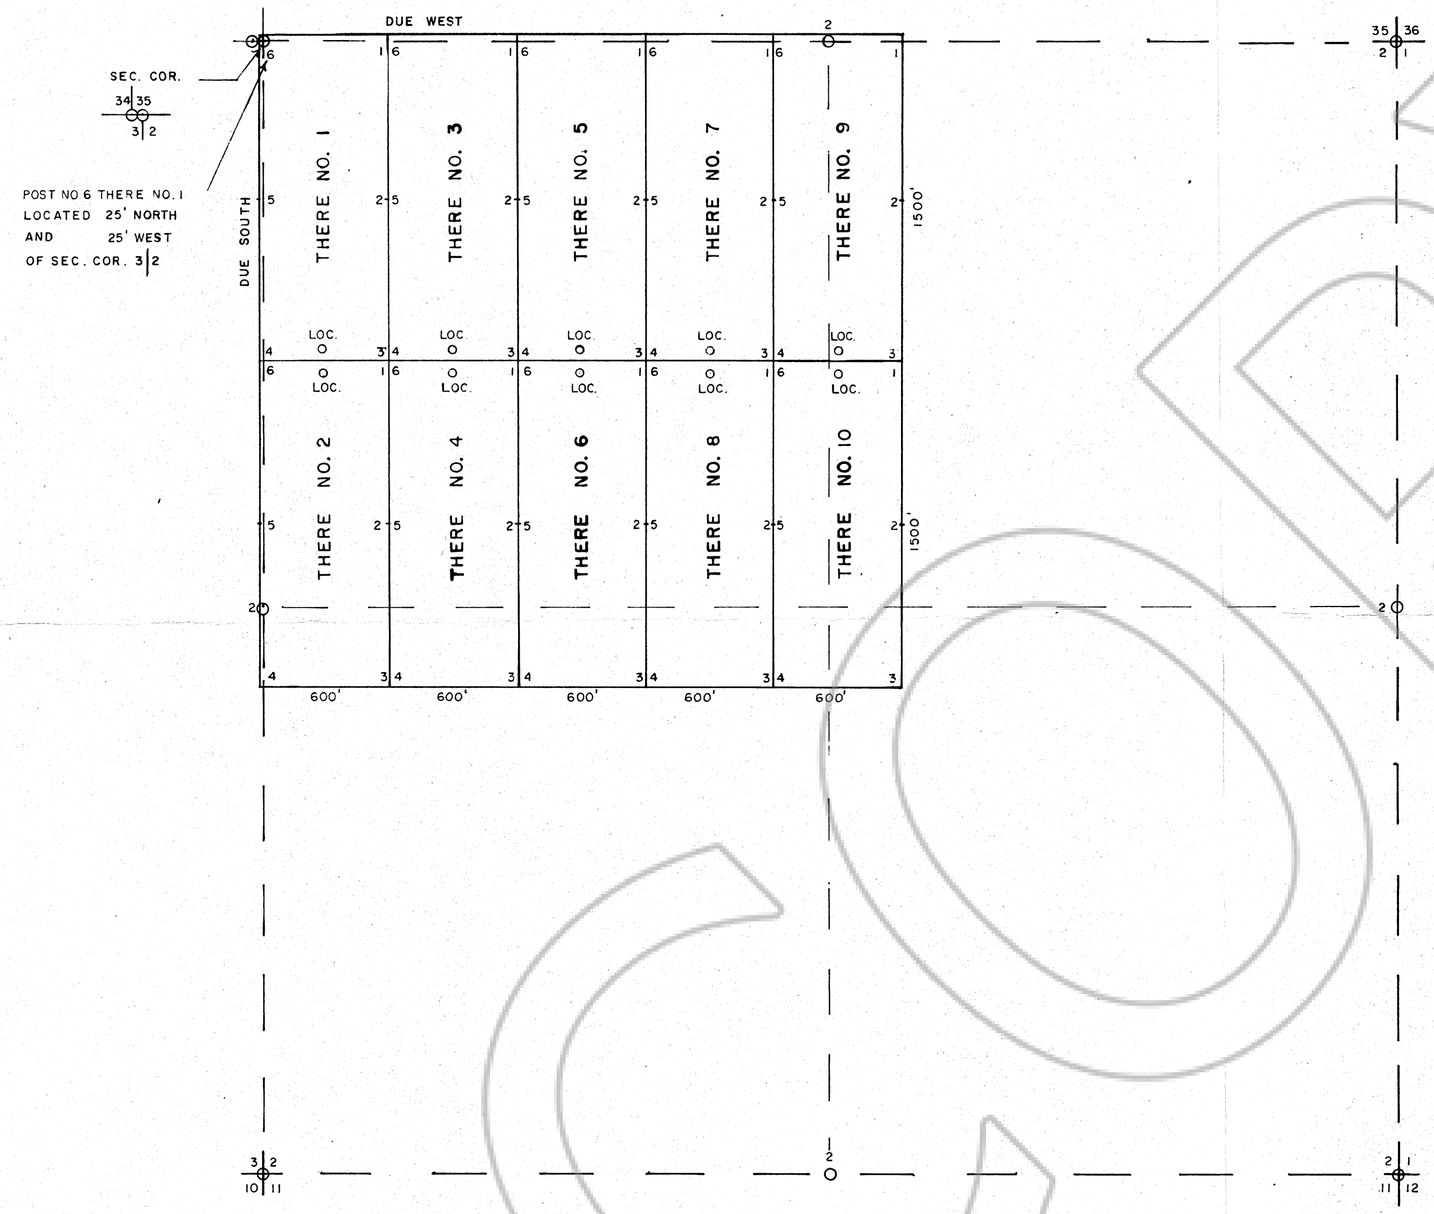

N

ALL LOCATION POSTS CENTERED AND 50' FROM CLAIM LINE

ALL CORNERS ARE 4" X 4" X 4-1/2' WOODEN POSTS
MARKED WITH ALUMINUM DYMO TAPE

LOCATION OF POSTS
NO. 1 N.E. COR.
NO. 2 E.S.C.
NO. 3 S.E. COR.
NO. 4 S.W COR
NO. 5 W.S.C.
NO. 6 N.W. COR.

Filed
~~RECORDED~~ AT THE REQUEST OF Carlin Gold Mining Company
on December 16, 19 77, at 30 mins. past 1 P. M. In
~~Book~~ ~~OF OFFICIAL RECORDS~~, RECORDS OF
EUREKA COUNTY, NEVADA. WILLIS A. DePAOLI Recorder
File No. 64398 Fee $ 150.00

THERE GROUP CLAIMS

LOCATION: MAGGIE CREEK MINING DISTRICT
EUREKA COUNTY, NEVADA
SEC. 2 T33N R51E MDB&M

TYPE: LODE

SCALE: 1" = 500'

LOCATED BY: CARLIN GOLD MINING COMPANY
P.O. BOX 979
CARLIN, NEVADA 89822

DATE: NOVEMBER 1, 1977