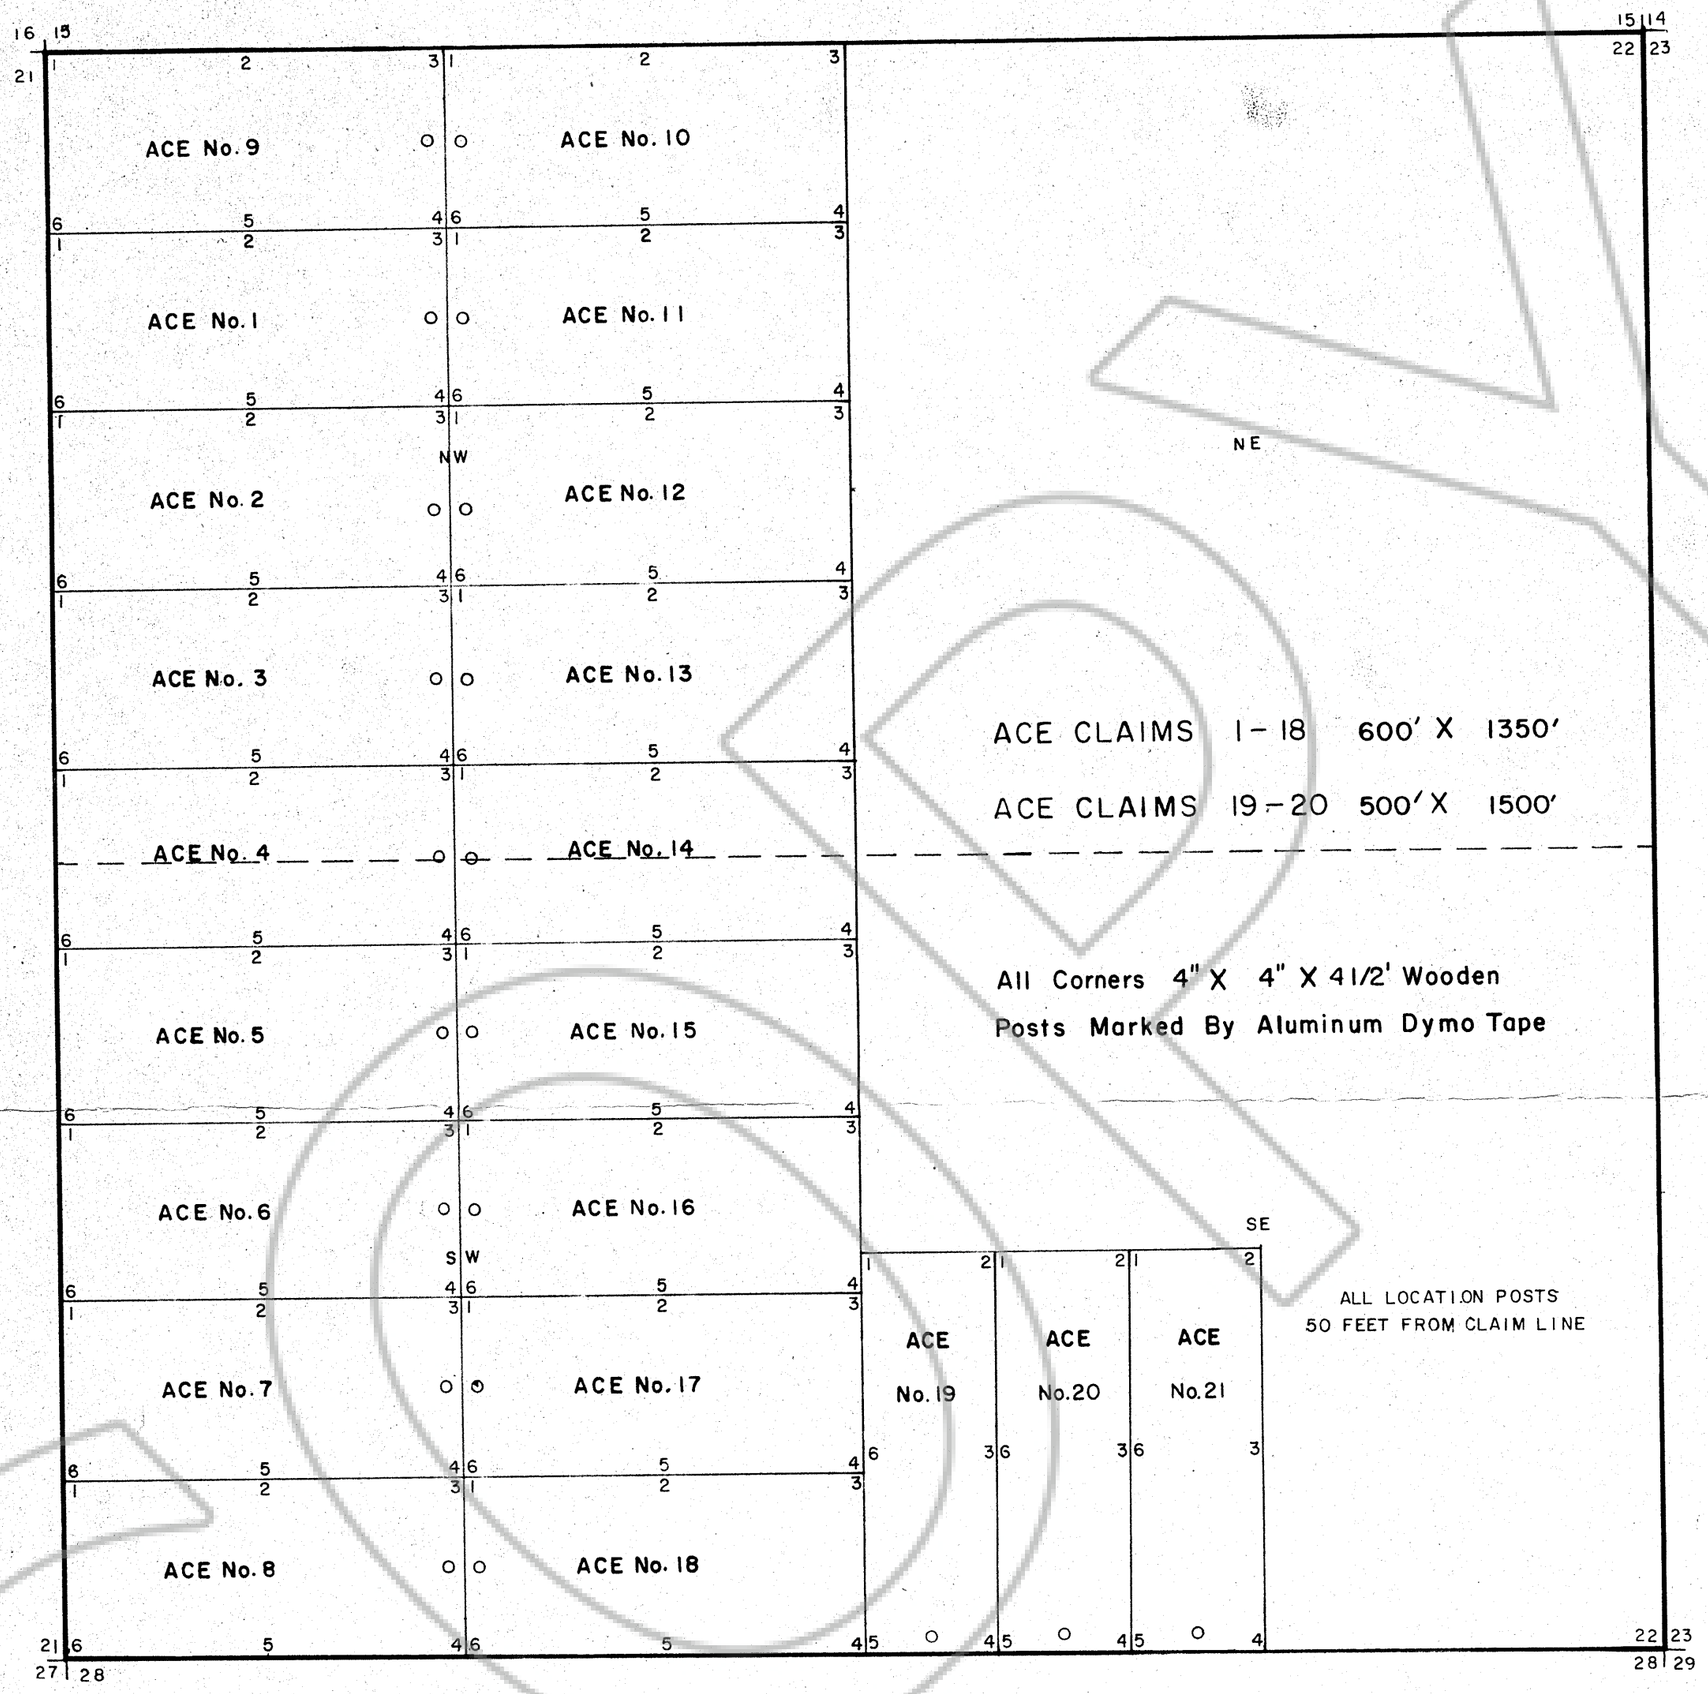

POST 1, ACE No. 9 LOCATED AT SECTION CORNER 16|15 / 21|22

POST 6, ACE No. 8 LOCATED AT SECTION CORNER 21|22 / 27|28

POST 4, ACE No. 18 AND POST 5, ACE No. 19 LOCATED AT SOUTH 1/4 CORNER

N

Filed
~~RECORDED~~ AT THE REQUEST OF
Carlin Gold Mining Co.
on August 25, 1978
at 16 mins. past 11 A M.
~~In Book~~ ~~of OFFICIAL~~
~~RECORDS, page~~, RECORDS
OF EUREKA COUNTY, NEVADA
WILL A. DePAOLI
Recorder
File No. 65963 Fee $ 315.00

ACE CLAIMS

LOCATION: MAGGIE CREEK MINING DISTRICT
EUREKA COUNTY, NEVADA
SEC. 22 T.34 N., R.51 E., M.D.B. & M.

TYPE: LODE

SCALE: 1" = 500'

LOCATED BY: CARLIN GOLD MINING COMPANY
P.O. BOX 979
CARLIN, NEVADA 89822

DATE: 22 JUNE 1978