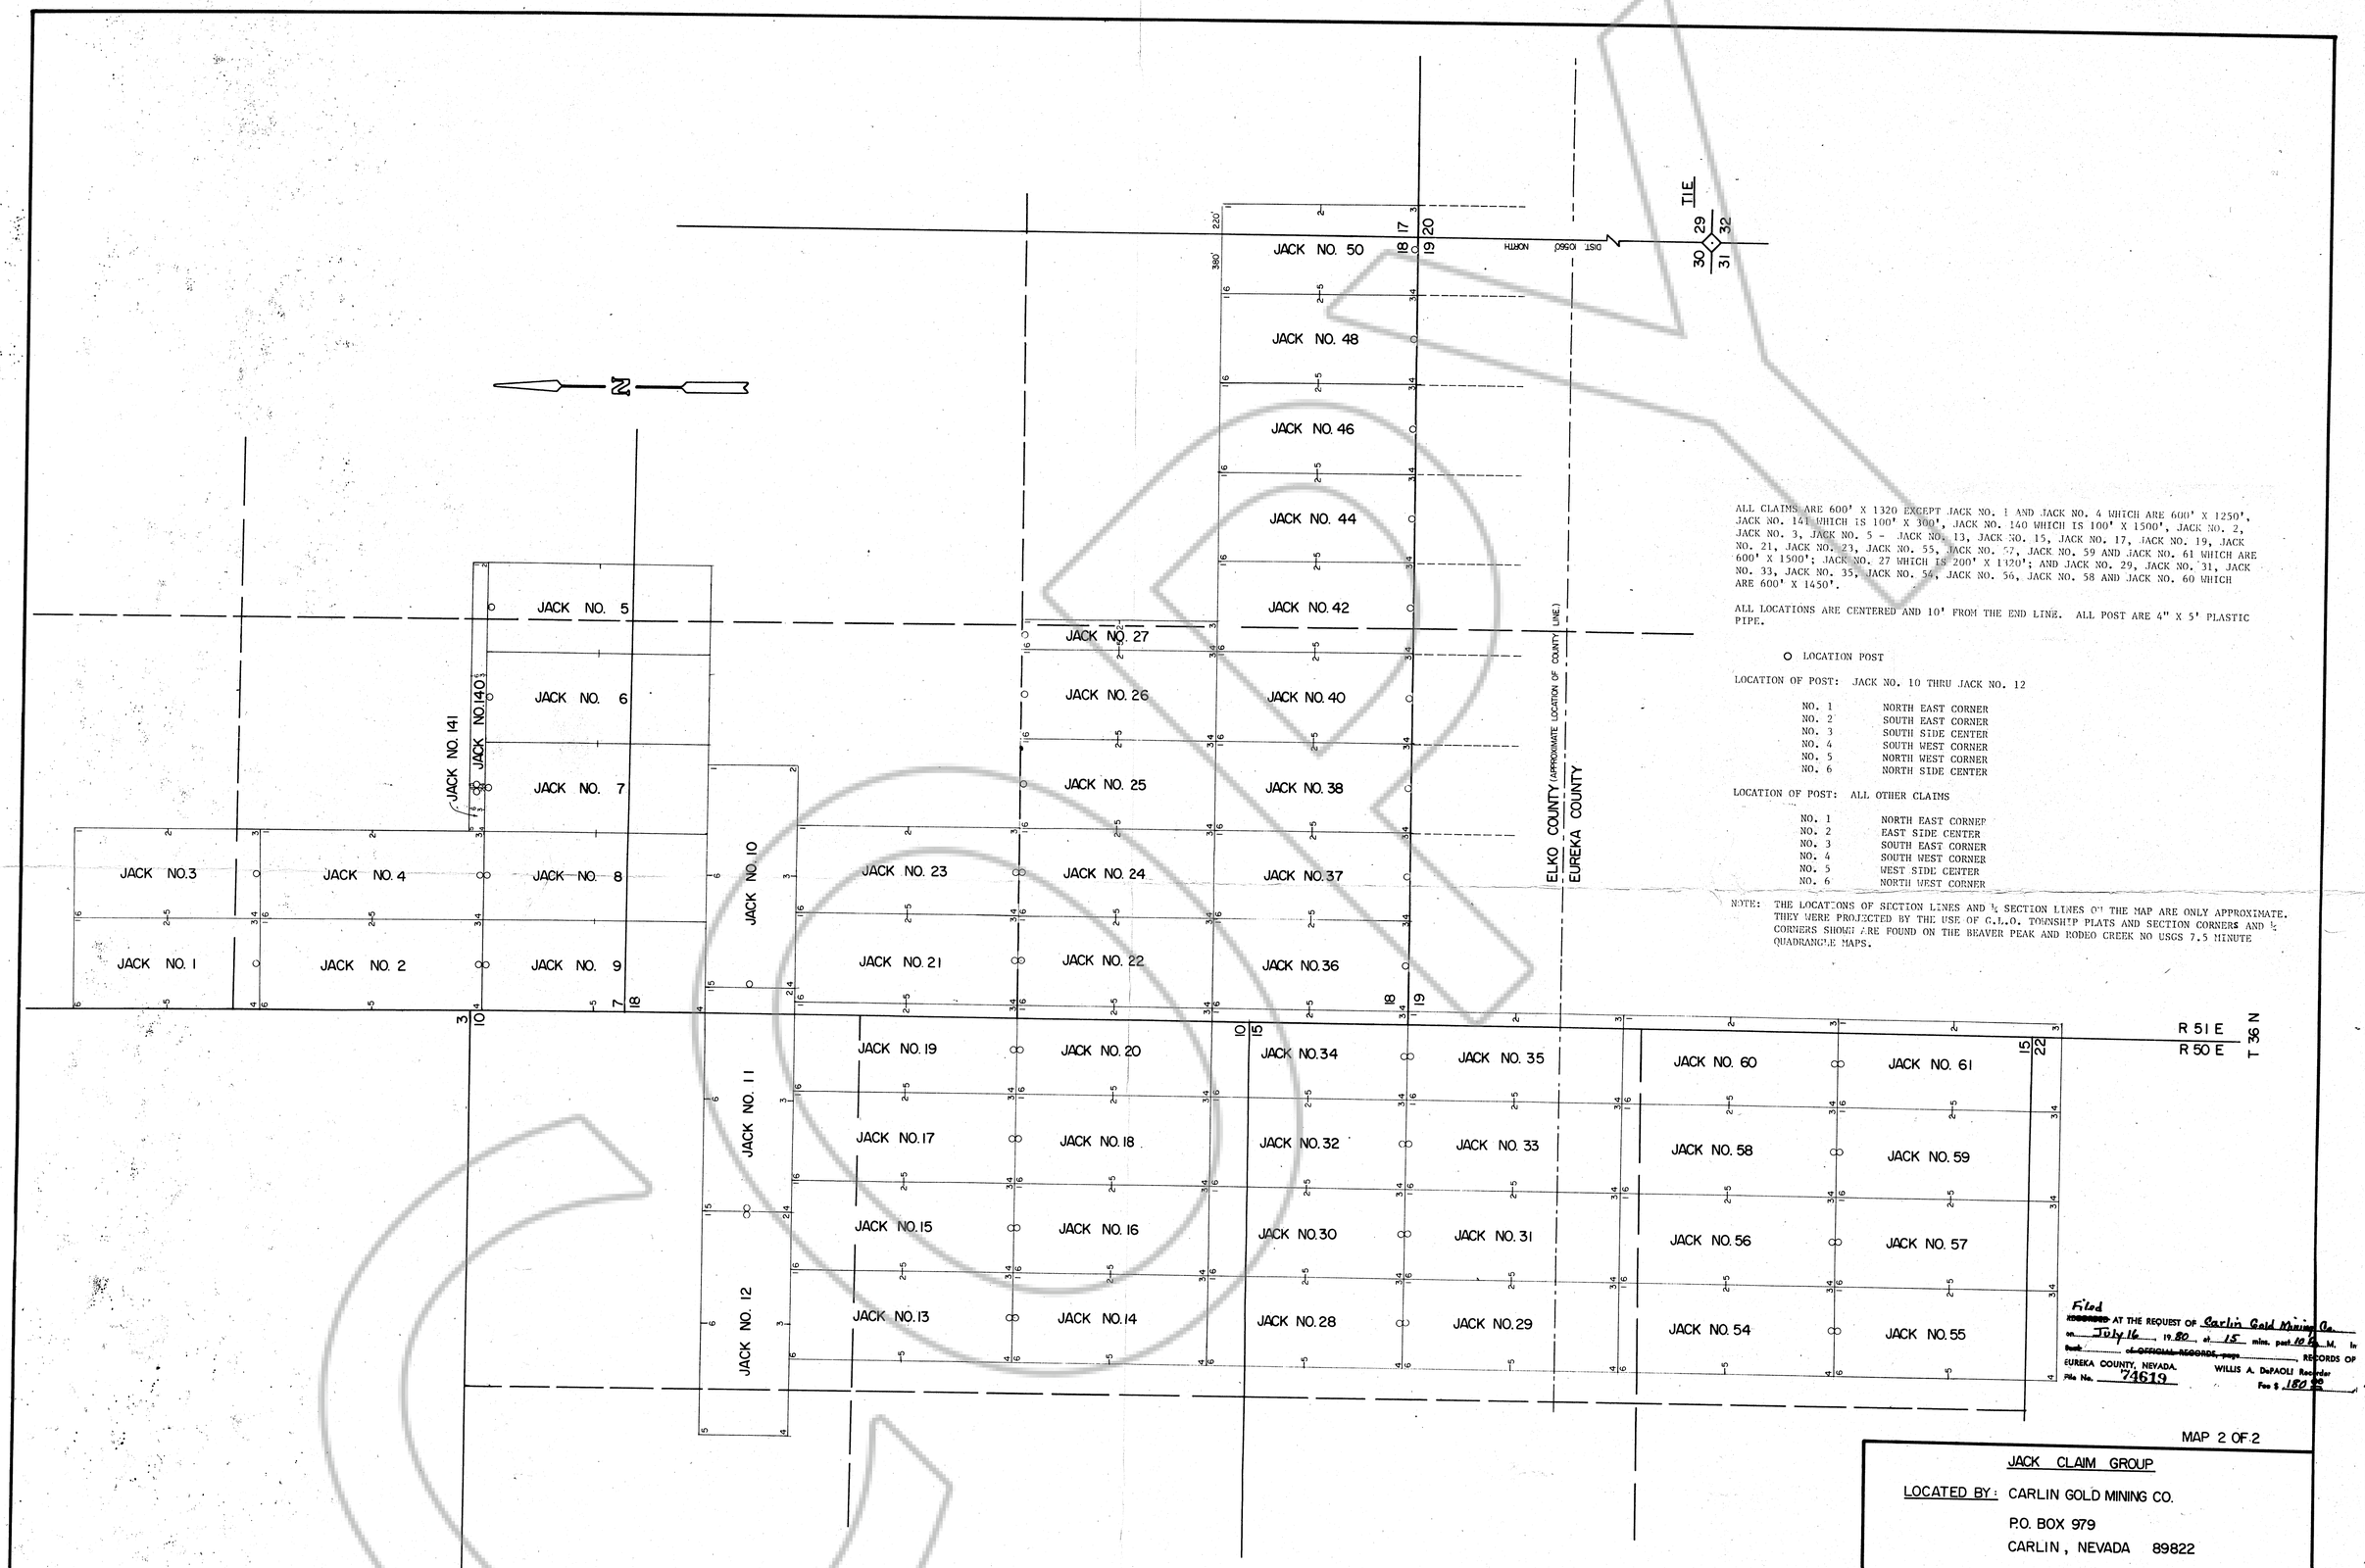

ALL CLAIMS ARE 600' X 1320 EXCEPT JACK NO. 1 AND JACK NO. 4 WHICH ARE 600' X 1250', JACK NO. 141 WHICH IS 100' X 300', JACK NO. 140 WHICH IS 100' X 1500', JACK NO. 2, JACK NO. 3, JACK NO. 5 - JACK NO. 13, JACK NO. 15, JACK NO. 17, JACK NO. 19, JACK NO. 21, JACK NO. 23, JACK NO. 55, JACK NO. 57, JACK NO. 59 AND JACK NO. 61 WHICH ARE 600' X 1500'; JACK NO. 27 WHICH IS 200' X 1320'; AND JACK NO. 29, JACK NO. 31, JACK NO. 33, JACK NO. 35, JACK NO. 54, JACK NO. 56, JACK NO. 58 AND JACK NO. 60 WHICH ARE 600' X 1450'.

ALL LOCATIONS ARE CENTERED AND 10' FROM THE END LINE. ALL POST ARE 4" X 5' PLASTIC PIPE.

O LOCATION POST

LOCATION OF POST: JACK NO. 10 THRU JACK NO. 12

NO. 1	NORTH EAST CORNER
NO. 2	SOUTH EAST CORNER
NO. 3	SOUTH SIDE CENTER
NO. 4	SOUTH WEST CORNER
NO. 5	NORTH WEST CORNER
NO. 6	NORTH SIDE CENTER

LOCATION OF POST: ALL OTHER CLAIMS

NO. 1	NORTH EAST CORNER
NO. 2	EAST SIDE CENTER
NO. 3	SOUTH EAST CORNER
NO. 4	SOUTH WEST CORNER
NO. 5	WEST SIDE CENTER
NO. 6	NORTH WEST CORNER

NOTE: THE LOCATIONS OF SECTION LINES AND ¼ SECTION LINES ON THE MAP ARE ONLY APPROXIMATE. THEY WERE PROJECTED BY THE USE OF G.L.O. TOWNSHIP PLATS AND SECTION CORNERS AND ¼ CORNERS SHOWN ARE FOUND ON THE BEAVER PEAK AND RODEO CREEK NO USGS 7.5 MINUTE QUADRANGLE MAPS.

Filed
~~RECORDED~~ AT THE REQUEST OF Carlin Gold Mining Co.
on July 16, 1980, at 15 mins. past 10 A.M. In
~~Book~~ ~~of OFFICIAL RECORDS, page~~ RECORDS OF
EUREKA COUNTY, NEVADA. WILLIS A. DePAOLI Recorder
File No. 74619 Fee $ 180.00

MAP 2 OF 2

DATE OF LOCATION: MAP 2 of 2

All above claims located on May 20, 1980, except Jack No. 4, No. 7, No. 8, No. 10, No. 27, No. 140, and No. 141 which were located on July 2, 1980.

JACK CLAIM GROUP

LOCATED BY: CARLIN GOLD MINING CO.
P.O. BOX 979
CARLIN, NEVADA 89822

LOCATION: UNKNOWN MINING DISTRICT

SECTIONS:
7, 17 & 18
T36N, R51E
10, & 15
T36N, R50E
M.D.B & M.

CLAIM TYPE: LODE

SCALE: 1" = 500'

74619