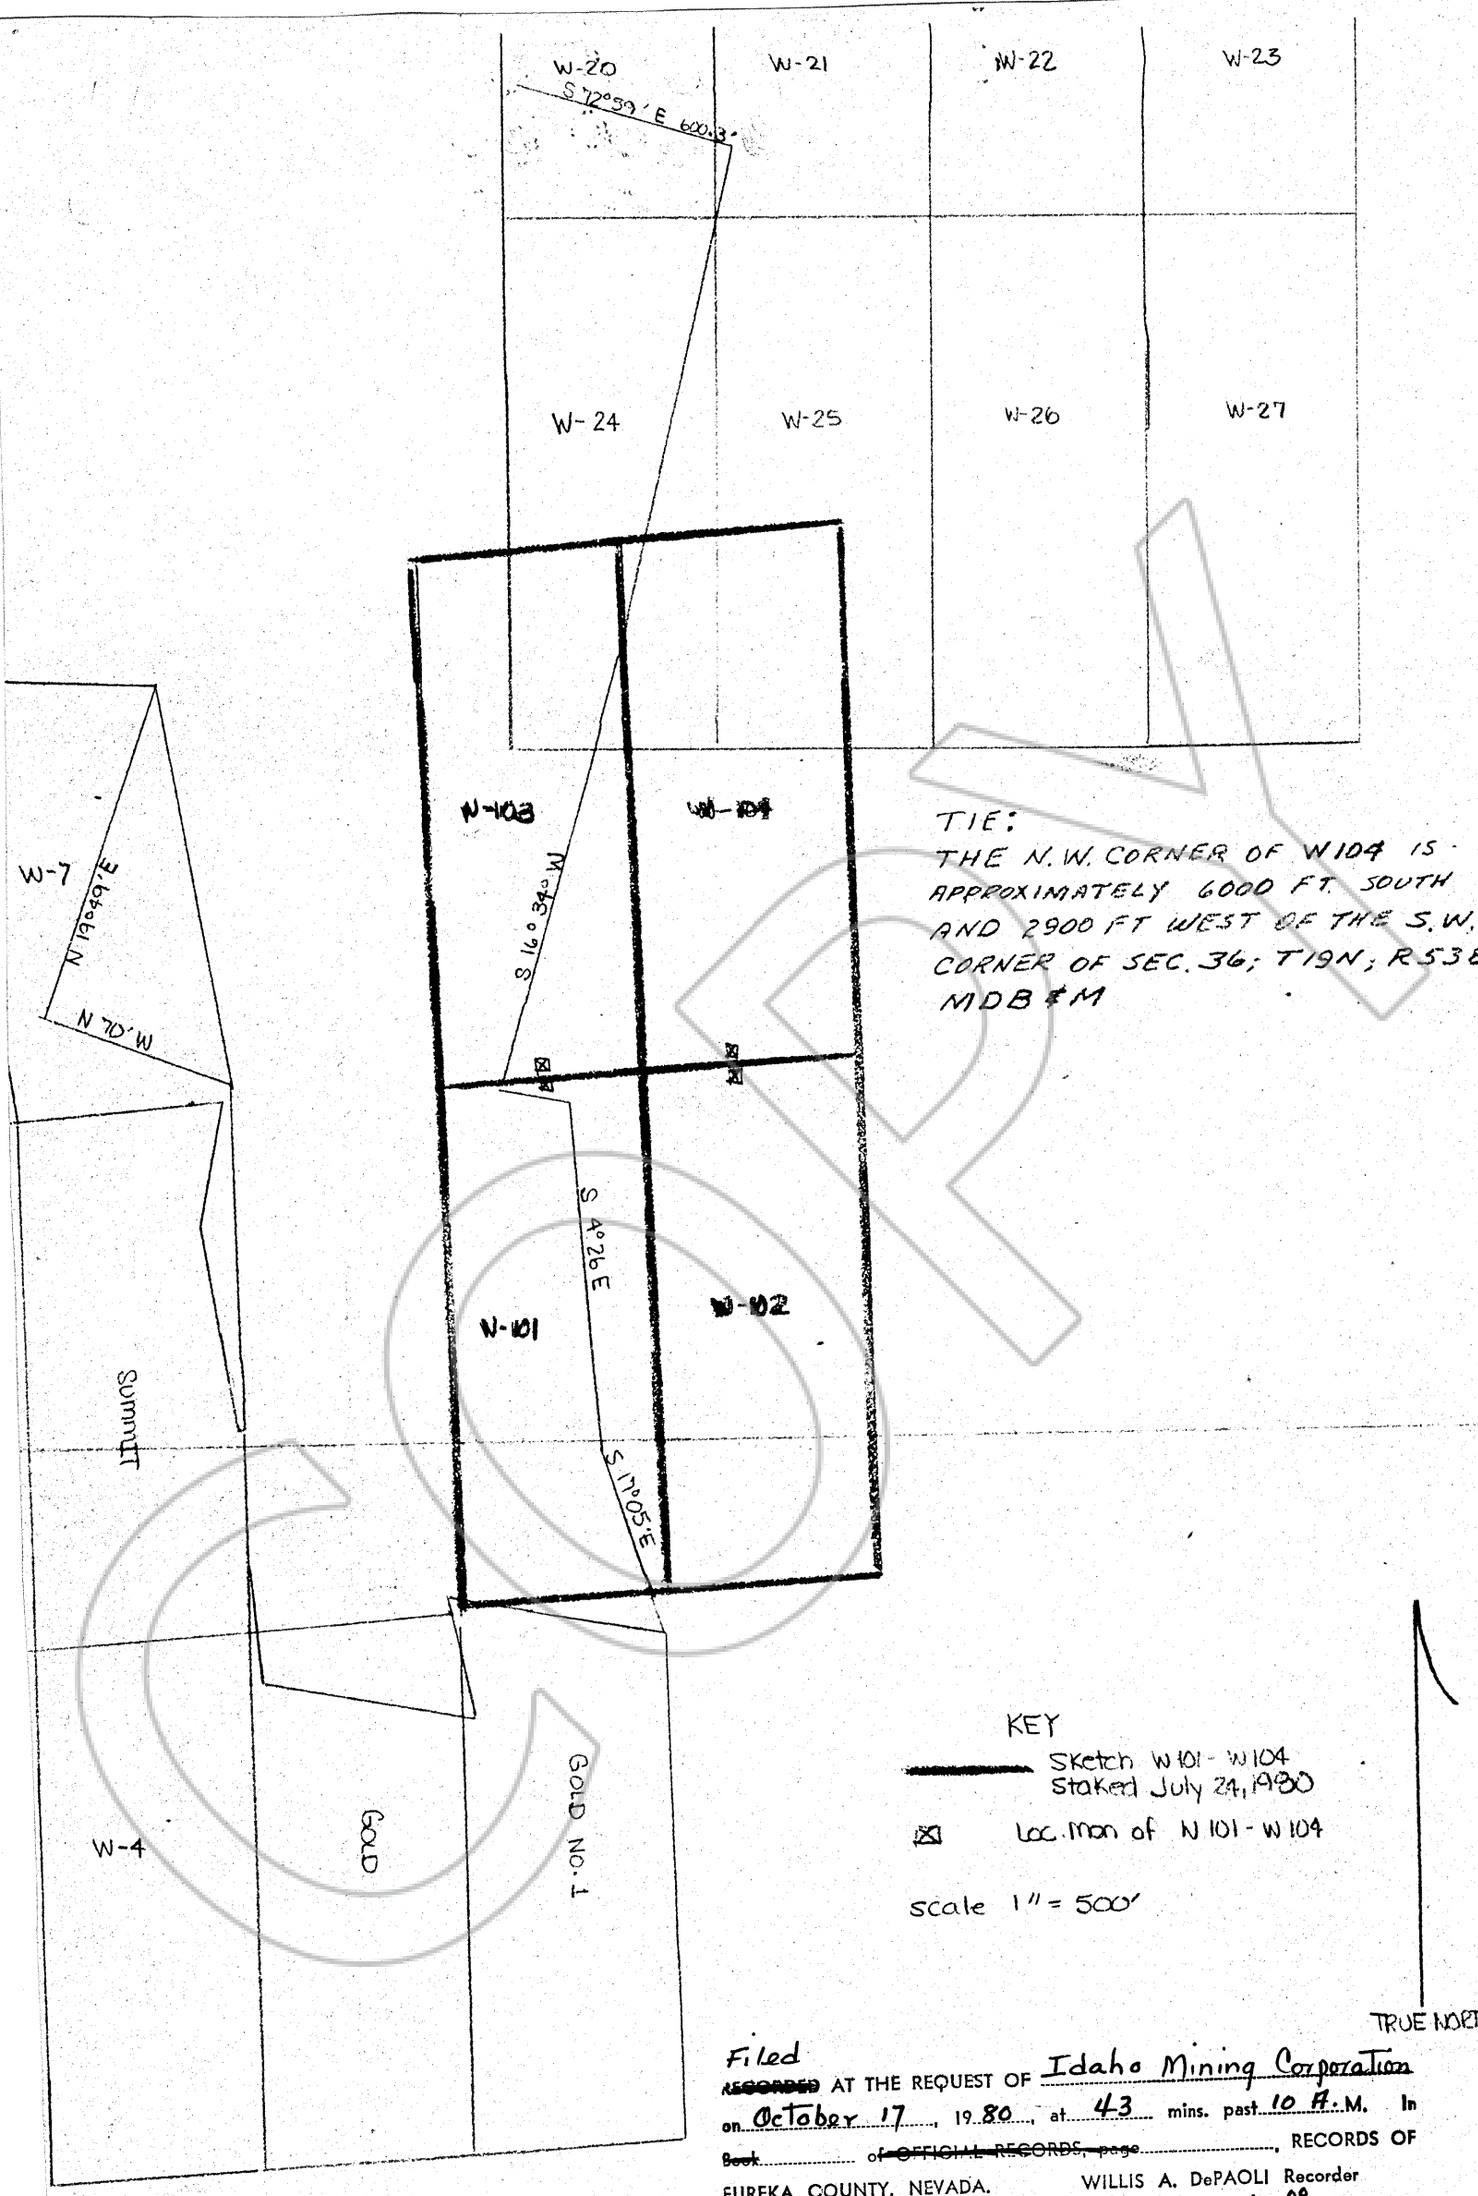

Filed

~~RECORDED~~ AT THE REQUEST OF Idaho Mining Corporation

on October 17, 19 80, at 43 mins. past 10 A.M. In

~~Book~~ ..... of ~~OFFICIAL RECORDS, page~~ ....., RECORDS OF

EUREKA COUNTY, NEVADA. WILLIS A. DePAOLI Recorder

File No. 77132 Fee $ 60.00

IDAHO MINING CORPORATION
W-CLAIM GROUP (LODE)

DRAWN BY Ann Chadburn
August 25, 1980

77132