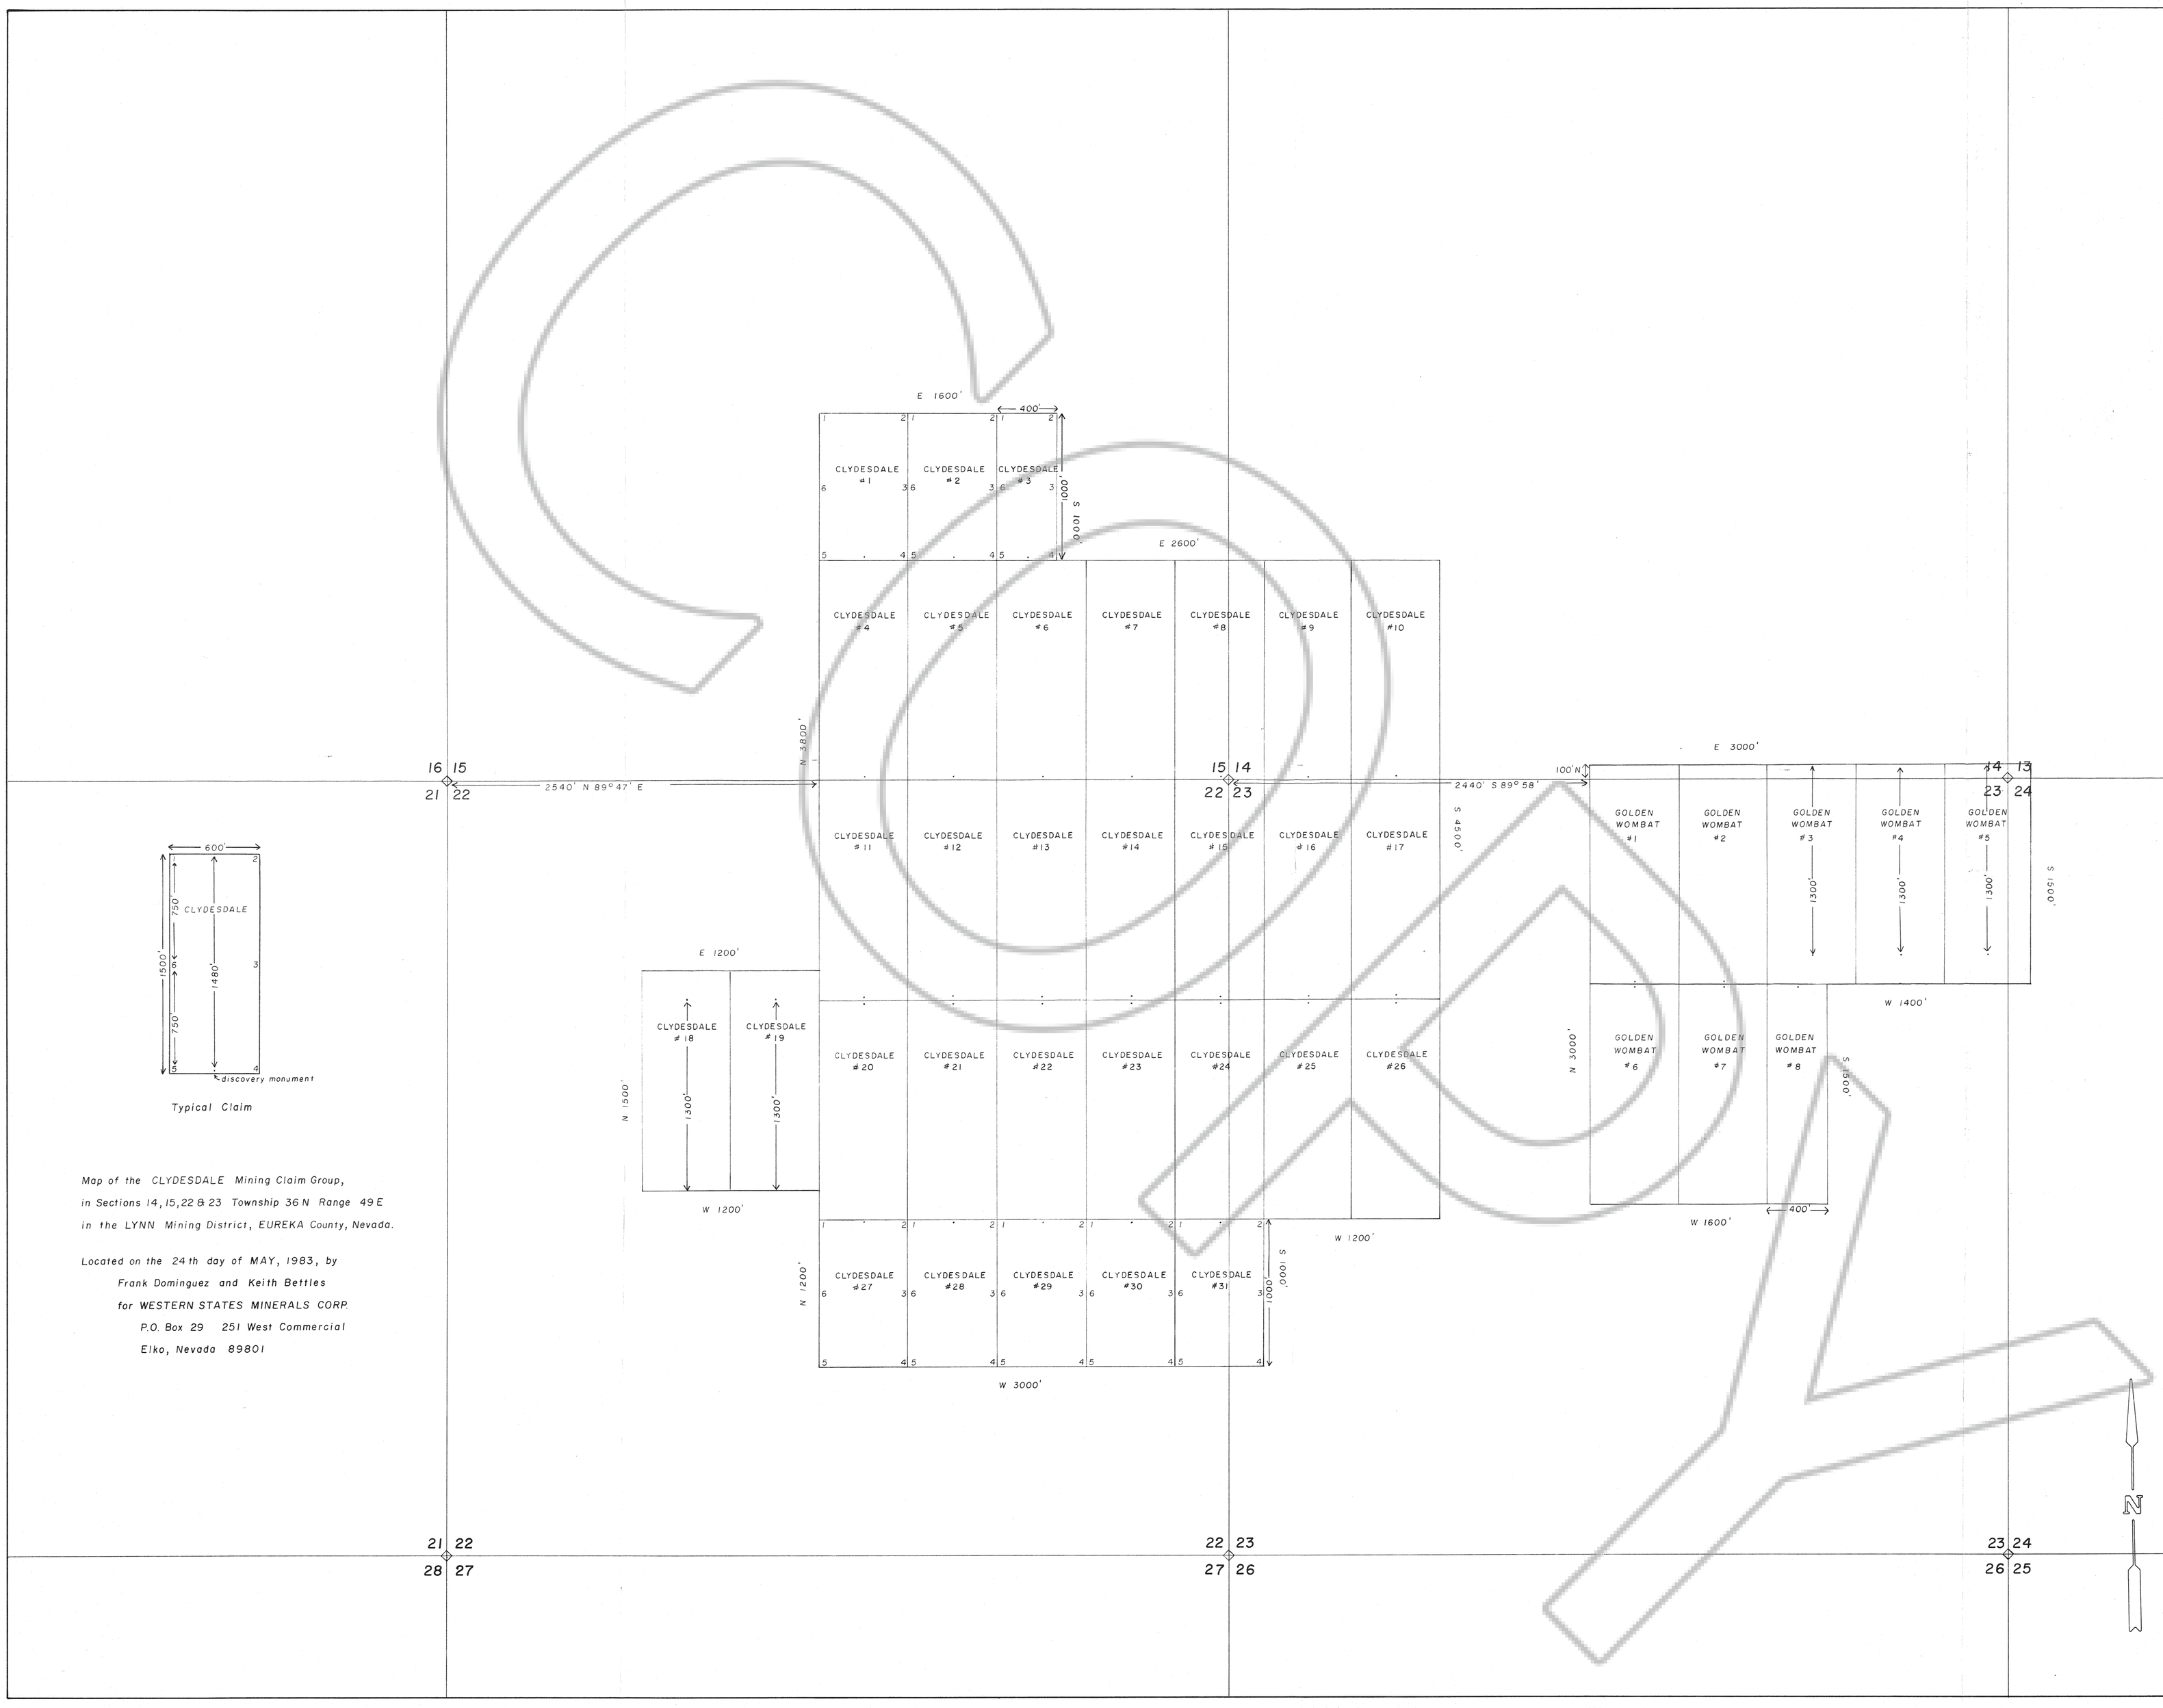

Map of the CLYDESDALE Mining Claim Group,
in Sections 14, 15, 22 & 23 Township 36 N Range 49 E
in the LYNN Mining District, EUREKA County, Nevada.

Located on the 24th day of MAY, 1983, by
Frank Dominguez and Keith Bettles
for WESTERN STATES MINERALS CORP.
P.O. Box 29 251 West Commercial
Elko, Nevada 89801

Map of the GOLDEN WOMBAT Mining Claim Group,
in Sections 13, 14, 23 & 24 Township, 36 N Range 49 E,
in the LYNN Mining District, EUREKA County, Nevada.

Located on the 24th day of MAY, 1983, by
Frank Dominguez and Keith Bettles Keith Bettles 7-16-83
for WESTERN STATES MINERALS CORP.
P.O. Box 29 251 West Commercial
Elko, Nevada 89801

Filed ~~RECORDED~~ AT THE REQUEST OF **WESTERN STATES MINERALS**
on July 18, 19 83, at 49 mins. past 10 A. M. In
~~book~~ _____ of ~~OFFICIAL RECORDS, page~~ _____, RECORDS OF
EUREKA COUNTY, NEVADA. M.N. REBALEATI, Recorder
File No. 88190 Fee $ 525.00

Western States Minerals Corporation
Post Office Box 29 Elko, Nevada 89801

CLYDESDALE & GOLDEN WOMBAT CLAIMS

AUTHOR: K. Bettles	DRAFTED: L. Noeske		DATE: 6/21/83
DESIGNED:	SCALE: 1" = 500'	Dwg. No.:	
REVISED:	CHECKED:	FILE:	FIG:
REMARKS:			

88190