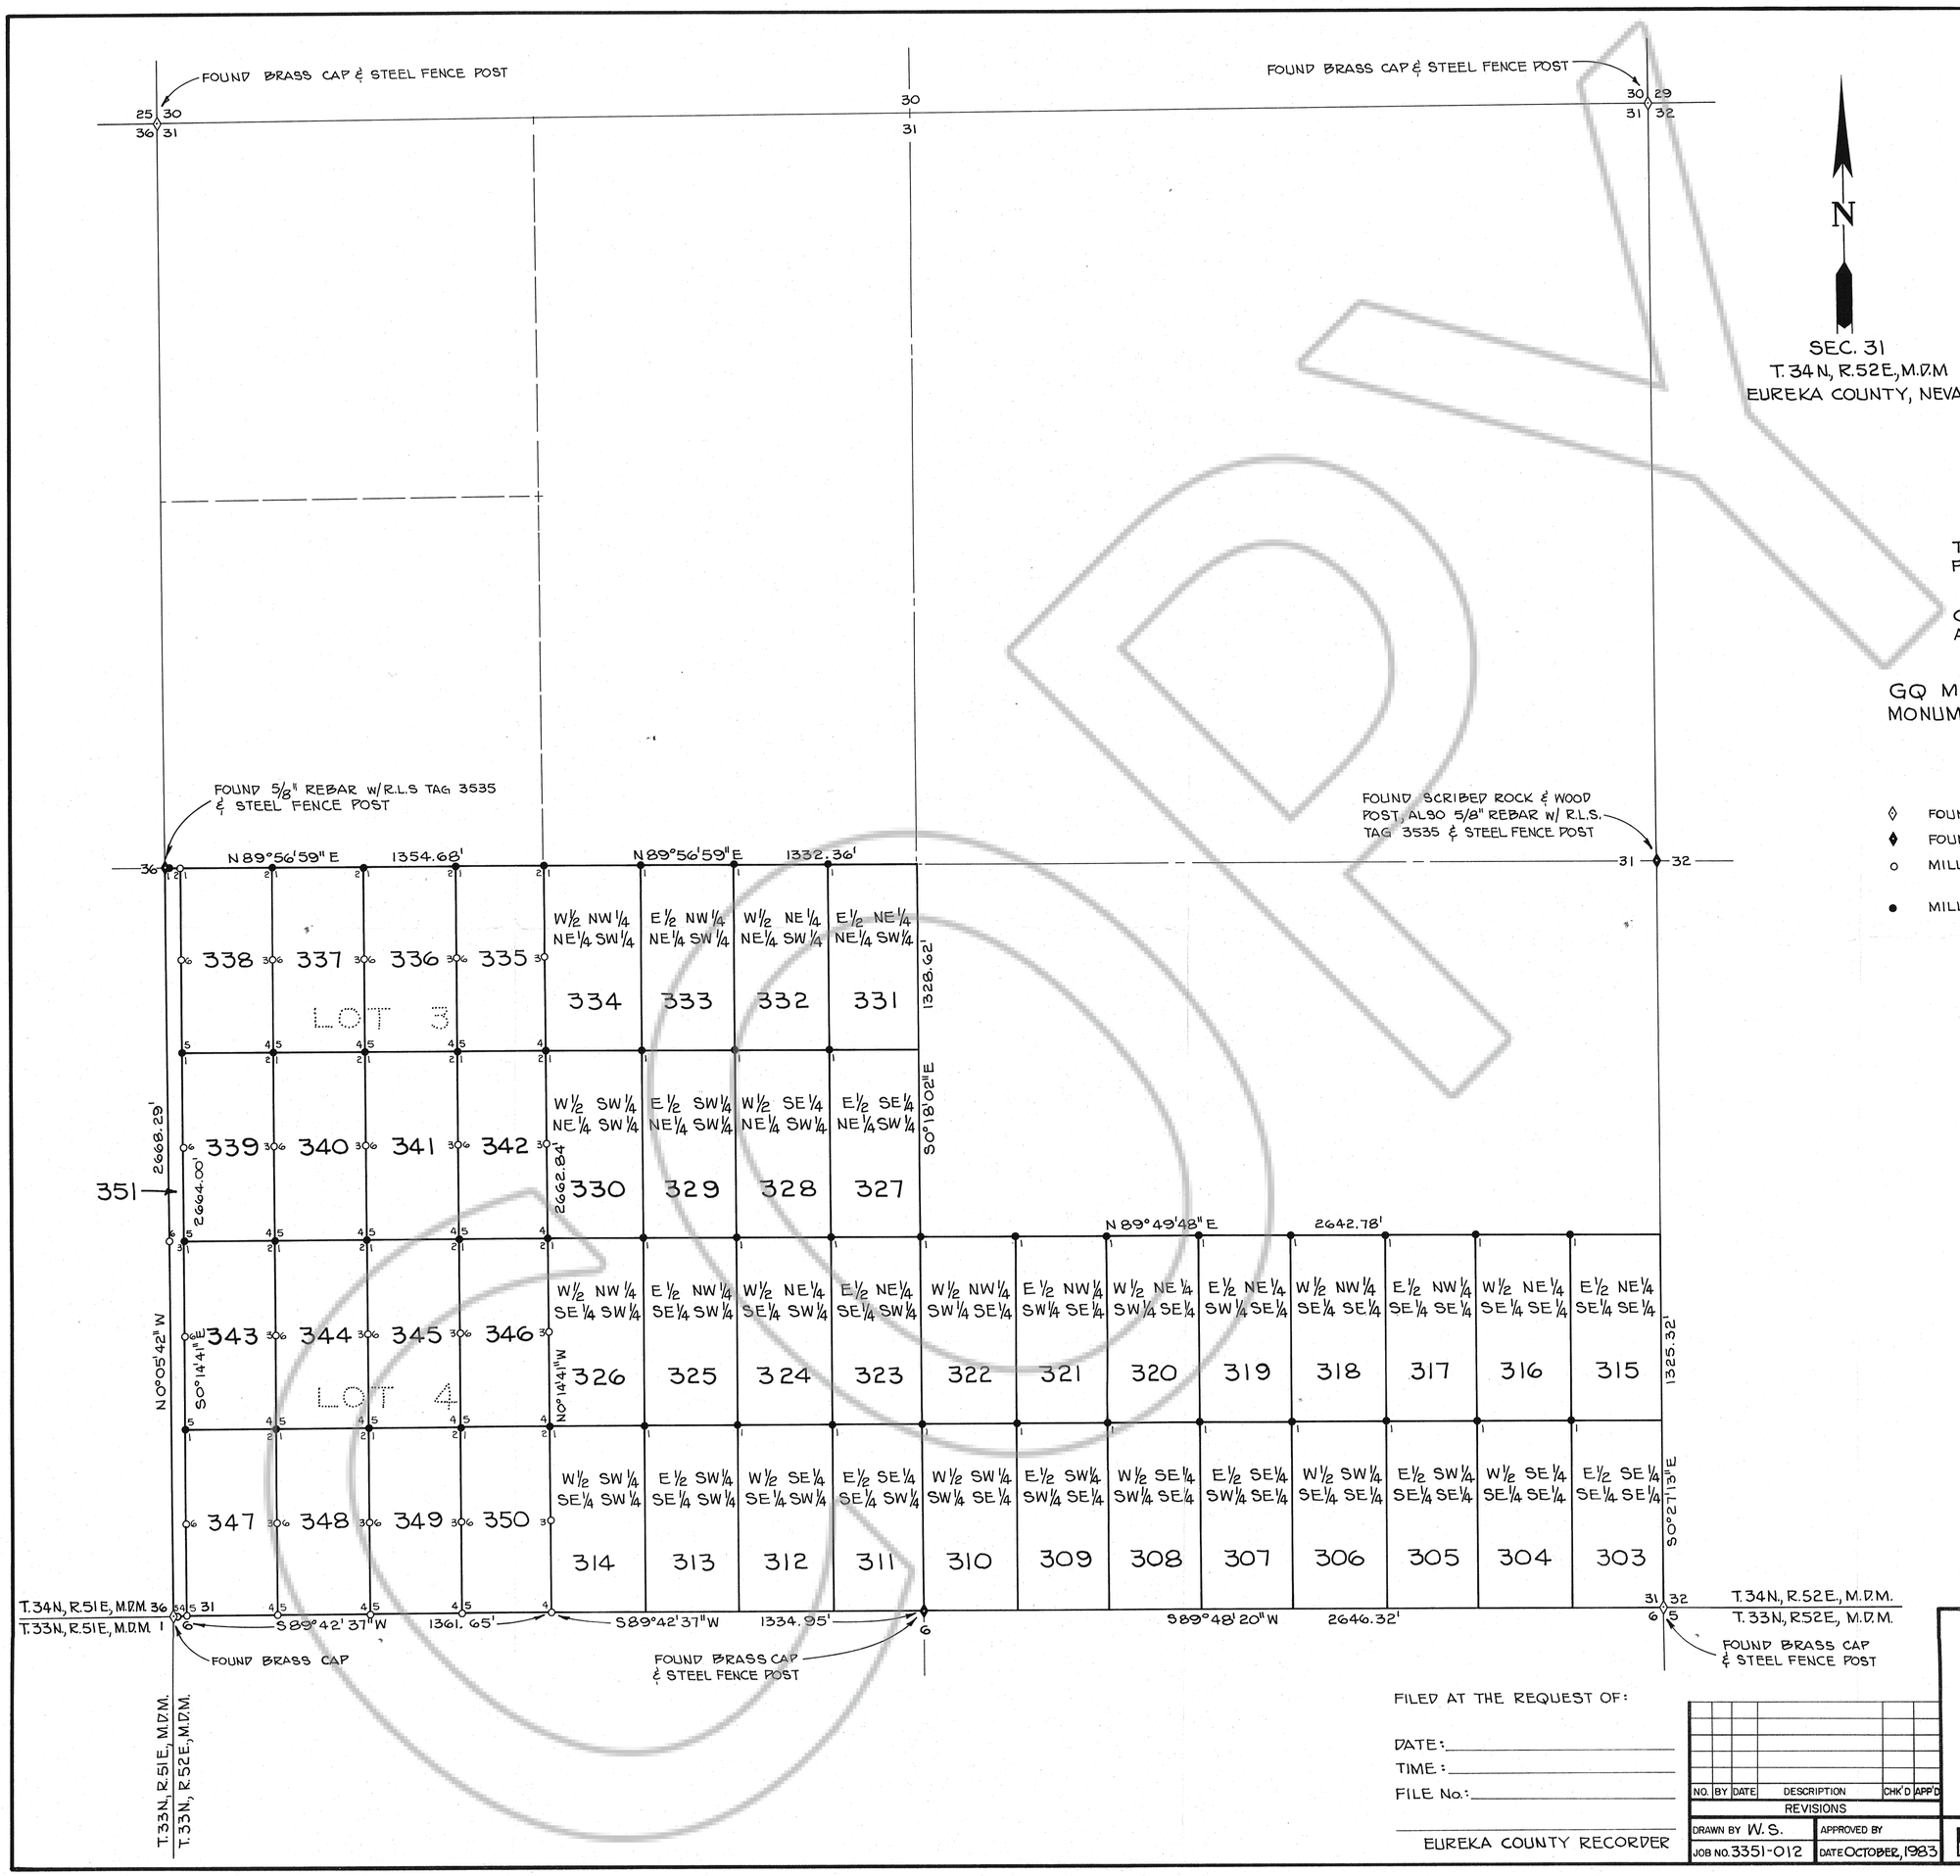

N

SEC. 31
T. 34 N., R. 52 E., M.D.M.
EUREKA COUNTY, NEVADA

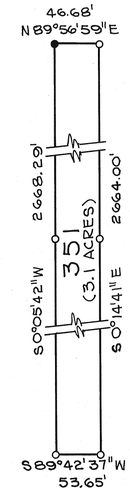

TYPICAL DIMENSIONING FOR GQ 351 MILLSITE CLAIM

TYPICAL CLAIM DIMEN
FOR GQ 335-350 M
CLAIMS

GQ 303-334 MILLSITE CLAIMS ARE TAKE
AN ALLQUOT PART OF THE RECTANGULA
SURVEY SYSTEM.

GQ MILLSITE CLAIMS 303-351 WERE LOCAT
MONUMENTATION COMPLETED ON: OCTOBER 12,

LEGEND

- ◇ FOUND SECTION CORNER
- ◆ FOUND ¼ SECTION CORNER
- ○ MILLSITE CLAIM POST - 4" DIA x 5'-0" P.V.C. PIPE W/ APPROPR MARKED FOR CORNER.
- ● MILLSITE LOCATION MONUMENT - 4" DIA. x 5'-0" P.V.C. PIPE, L IN NW CORNER OF MILLSITE CLAIM W/ LOC NOTICE.

Filed
~~RECORDED~~ AT THE REQUEST OF CARLIN GOLD MINING COMPANY
on November 2, 19 83, at 10 mins. past 1 P. M. In
~~book~~ _____ ~~of OFFICIAL RECORDS, page~~ _____, RECORDS OF
EUREKA COUNTY, NEVADA.
File No. 90182
M.N. REBALEATI, Recorder
Fee $ 735.00

0 300 600 900 1200

SCALE: 1" = 300'

FILED AT THE REQUEST OF:

DATE: _____

TIME: _____

FILE No.: _____

EUREKA COUNTY RECORDER

NO.	BY	DATE	DESCRIPTION	CHK'D	APP'D

REVISIONS

DRAWN BY W. S.
APPROVED BY
JOB NO. 3351-012
DATE OCTOBER, 1983

MAP OF

GQ MILLSITE CLAIMS 303-3

SITUATED IN SECTION 31, T.34N., R.52E., M.D.M. - SURVE
FOR
CARLIN GOLD MINING COMPANY
A DELAWARE CORPORATION
P.O. BOX 979
CARLIN, NEVADA 89822

CHILTON ENGINEERING CHARTERED
ELKO, NEVADA RENO, NEVADA

8307