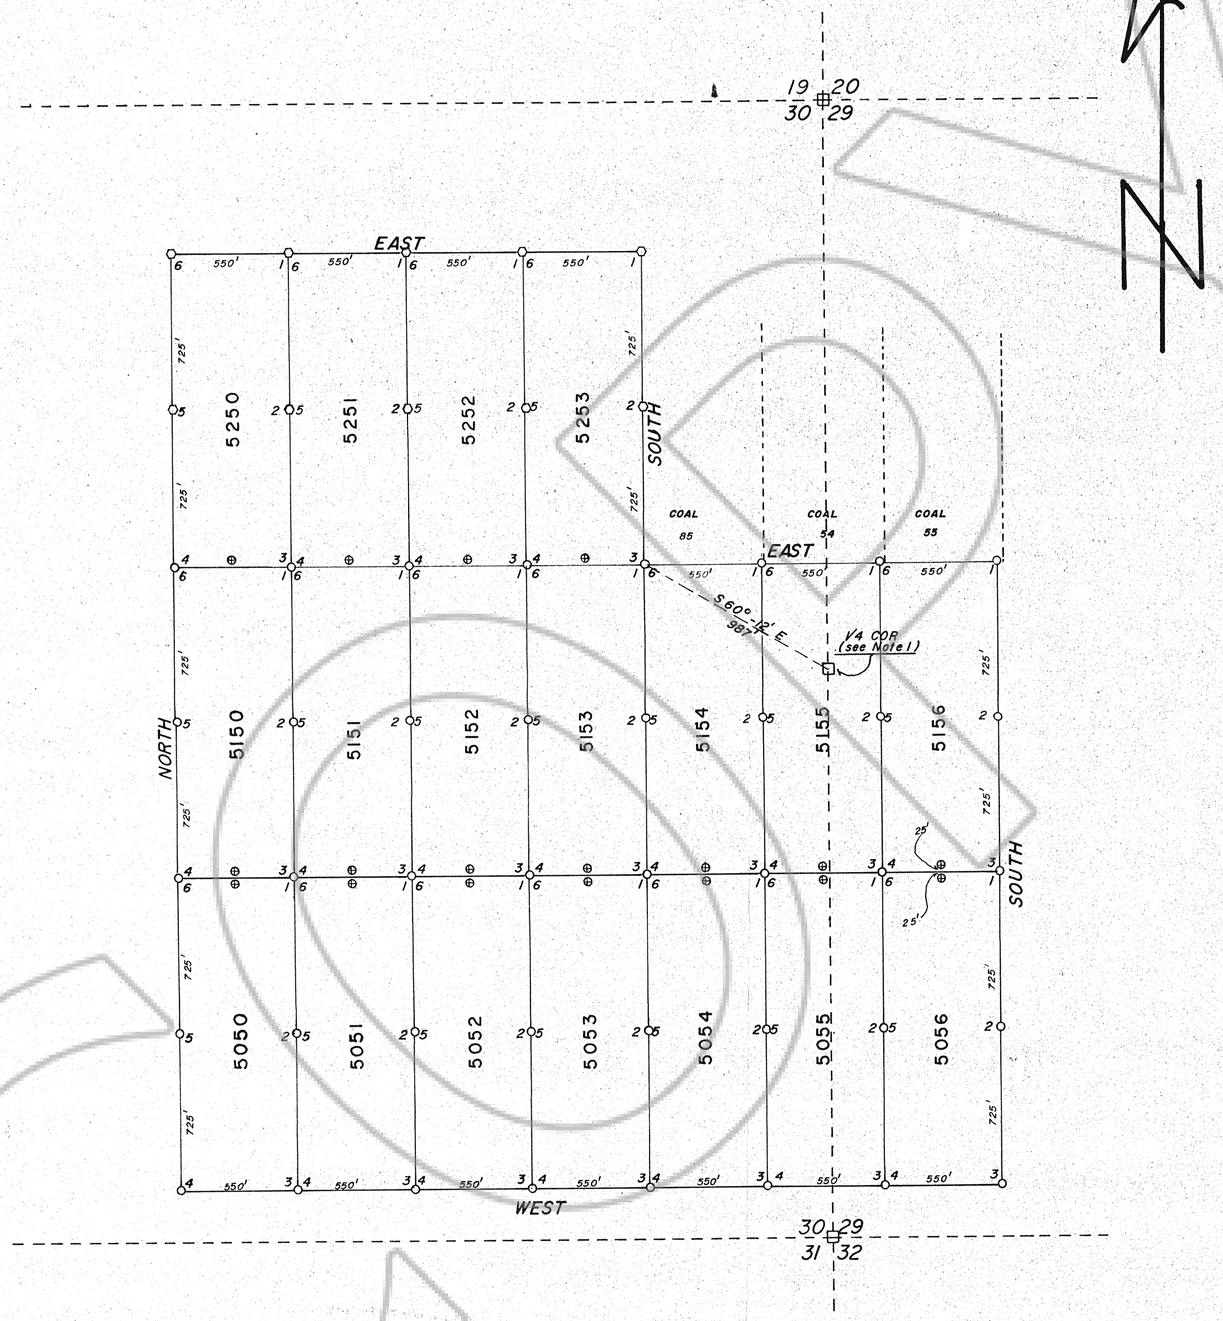

TOWNSHIP 25 NORTH, RANGE 49 EAST
MOUNT DIABLO MERIDIAN
EUREKA COUNTY, NEVADA

CLAIM NAME	LOCATION DATE	MONUMENTATION DATE
5050 thru 5056	9-17-83	9-18-83
5150 thru 5153	9-17-83	9-18-83
5154 thru 5156	9-17-83	9-24-83
5250 thru 5253	9-17-83	9-24-83

All location monuments are set 25' in from end lines depicted on map.

NOTE 1 – Found Brass Cap set on Iron Pipe & marked 1/4, S30 S29, 1922.

NOTE 2 – Section corner – Searched for, not found.

○ —— Monument – 4'6" PVC Pipe, 4" in diameter.

○ —— Monument – 4'6" x 4" x 4" Wood Post.

⊕ —— Location Monument – 4'6" x 4" x 4" Wood Post.

[redacted] AT THE REQUEST OF Minex Company
on November 7, 1983, at 48 mins. past 11 A.M. In
~~book~~ _____ ~~of OFFICIAL RECORDS, page~~ _____, RECORDS OF
EUREKA COUNTY, NEVADA. M.N. REBALEATI, Recorder
File No. 90338 Fee $ 270.00

F. C. Lode Claims

Sec 29 & 30, T 25 N, R 49 E, Eureka County, NV

SCALE: 1" = 500'		DRAWN BY: JAH
DATE: NOV 1, 1983		REVISED:
LOCATOR: COMINCO AMERICAN INCORPORATED E. 15120 Euclid Spokane, WA 99216		
AGENT: MINEX COMPANY P. O. Box 1949 Glendale, AZ 85311		DRAWING NUMBER 83-11-1

90338